


CERTIFIED RECORD OF LAND CORNER MONUMENTATION

9-21

History of original corner establishment:

Unsurveyed - subdivided section.

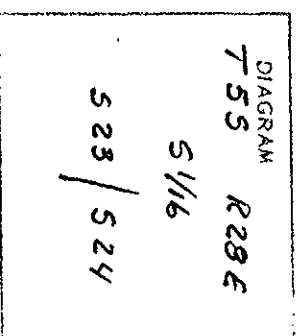

No record of subsequent remonumentation found in County Records.

Description of corner evidence found:

No evidence found.

I set the monument described below at a point midway between the found $1\frac{1}{4}$ and the SE corner of Section 23.

Description of monument and accessories established to perpetuate the original location of this corner

At the position described above, I set a $2\frac{1}{2}$ " x 30" iron pipe 27" in the ground with a brass cap marked as shown:

From which I scribed BTs:

A fir 5" in diam. bears 1130° W 7.6' marked S 1/16 S 23 BT.
A fir 15" in diam. bears 115° E 18.8' marked S 1/16 S 24 BT.

I nailed a brass washer marked PLS 1638 to BT blazes.


I set a steel fence post 5' North and 5' South with signs 54-2 & 4.

I painted a red band around BTs and face of scribe.

I used a steel tape and magnetic compass with 20° East variation and measured a horizontal distance to the center of the BTs.

This corner set September 4, 1979. Witness by Dennis L. Paasch.

See map of survey.

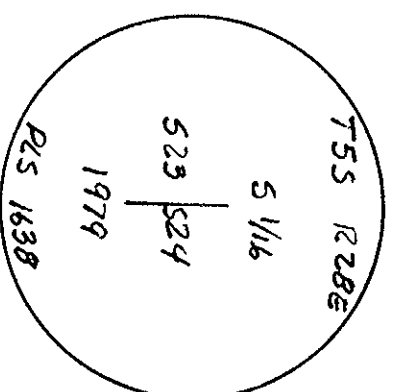

Office of County Surveyor Morrow
State of Oregon I hereby certify that the within instrument was filed in this office
For record on the 7th day of September
David H. Hambly
(COUNTY OFFICIAL) by (DEPUTY)

REGISTERED
PROFESSIONAL
LAND SURVEYOR

Dennis L. Paasch

OREGON
JULY 14, 1978
TERRY E. HAMBY
1638

RECEIVED BY

Morrow County Surveyor

Date 9-1-79

Rec'd By [Signature]