


CERTIFIED RECORD OF LAND CORNER MONUMENTATION

R-11

History of original corner establishment:

Corner originally established 1882 under Contract Survey No. 417, dated 1881.

Corner re-established by Dependent Resurvey authorized 1938 and approved Feb. 21, 1941.

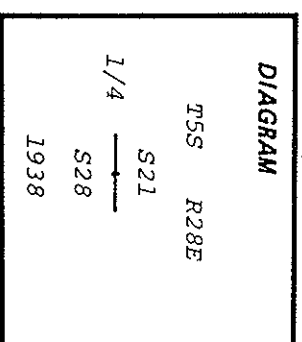

Description of corner evidence found:

1 inch iron pipe, with 2 1/2 inch brass cap marked as shown above,
From which---

8" L.P. Pine, dead and standing, bears N 49° E (record) 27.0' (record 27.1'),
scribing 1/4 S21 BT legible.

10" L.P. Pine, alive and standing, bears S 6° E (record S 12° E) 30.8' (record 30.4');
scribing 1/4 S28 BT legible.

Description of monument and accessories | established to perpetuate the
original location of this corner:

From Corner as found and as described above,

A new Bearing Tree, and 8" L.P. Pine, bears N 62° W, a distance of 30.4 feet, which
I marked 1/4 S21 BT.

Attached USFS signs, 54-3 and 54-4, to all Bearing Trees, and attached a brass tag,
marked R.L.S. 1024, to new tree. Painted blazes and a 6" band of fluorescent red
around trunks of all trees.

Set 6' steel fence post 5' East of Corner and attached USFS 54-2 over 54-4.

REGISTERED
PROFESSIONAL
LAND SURVEYOR

Thomas F. Upton

OREGON
FEBRUARY 14, 1975
THOMAS F. UPTON
1924

Office of CO. Surveyor County of MORROW Thomas F. Upton, Certificate No. R.L.S. 1024
State of Oregon hereby certify that the within instrument was filed in this office
for record on the 12th day of January 1982
Daniel H. Krumholtz Deputy Thomas A. Hughes
(COUNTY OFFICIAL) (DEPUTY)

Form R6-7100-57 (9/71)

RECEIVED BY

* GPO—798-276

Morrow County Surveyor

Date January 12, 1982

Rec'd By M. Hughes

No. 473-K

Ref. drawn on 2-1-1982