


RECORD OF LAND CORNER MONUMENTATION

EAST 1/16 CORNER SECTIONS 21 AND 28, T. 5 S., R. 28 E., W.M.

ORIGINALLY ESTABLISHED BY: Thomas F. Upton, PLS 1024

COUNTY SURVEYOR DOCUMENTATION: Map of Survey recorded 1/12/82 as C-460-K-465 and associated monumentation record filed 1/12/82

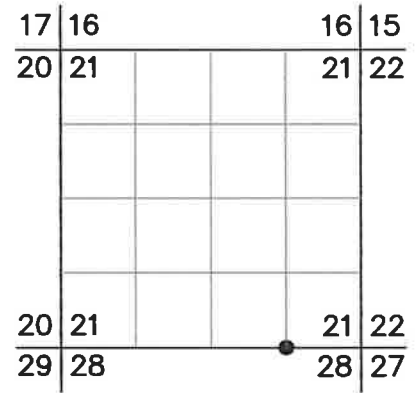

ORIGINAL DESCRIPTION: At the location of this corner, as established by a survey conducted by me, I set a 2 1/2 inch alum. pipe, 30 inches long, 2 feet in the ground, with an alum. cap marked as shown above.

From this monument as set,

- A new Bearing Tree, a 14" Fir, bears S 1° W a distance of 48.2 feet, which I marked E 1/16 S28 BT
- A new Bearing Tree, a 10" Lodgepole pine, bears N 36° W a distance of 42.7 feet, which I marked E 1/16 S21 BT

EVIDENCE FOUND: Found a 2 1/2" aluminum pipe with 2 3/4" aluminum cap projecting 1" above ground in a 2 ft. mound of stone. From which, I found the following bearing trees:

- ▶ A fir, dead and down, bears S.1°W.
- ▶ No trace of the lodgpole bearing tree could be found

DESCRIPTION OF MONUMENTS AND ACCESSORIES SET AND METHODS USED:
I accept the found aluminum monument for the true corner position.

From which, I SCRIBE THE FOLLOWING NEW BEARING TREE:


- ▶ A western larch, 11" dbh bears S84°E., 14.25 ft. marked "E1/16 S28" in upper blaze, and "BT" in lower blaze

I also SET THE FOLLOWING REFERENCE POINT:

- ▶ A 5/8"x30" iron pin driven flush with the ground bears N.34°W., 9.63 ft., with attached 2" aluminum cap marked "RP 1 2021 PLS 69454"

Painted a 6 inch red band around the bearing tree, and also painted the blaze red, and attached USFS signs 54-3 and 54-9. Distances measured with a steel tape. Distance to new bearing tree was measured to a 60d nail driven in the side-center-right at the root crown of the tree. Bearings were measured with a magnetic compass with 14° East declination.

MONUMENT MARKED:

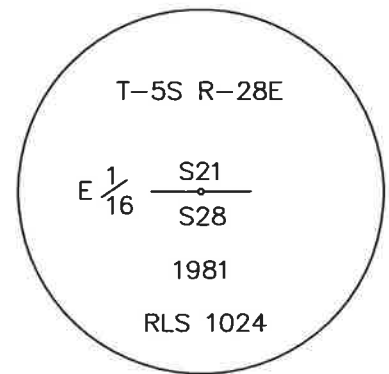

RESTORATION BY, STAMP AND DATE:

Work Performed October 5, 2021 by:

Jason L. Hatfield, PLS

USDA FOREST SERVICE
NORTHEAST OREGON LAND ZONE
1550 Dewey Avenue, Suite A
Baker City, OR 97814
(541) 523-1337

RECEIVED BY
Morrow County Surveyor

Date: 1-5-2022
Rec'd By: MPK
No.: SS 28 R12
Folder No.: _____



EXPIRES: 6/30/2023