

**CERTIFIED RECORD OF LAND CORNER MONUMENTATION**

Refer to: Plat of Penland 1988 Cadastrial Survey  
Section 22, T.5S., R.28E., W.M.

R-16

History of original corner establishment:  
No record of previous monumentation.

<b>DIAGRAM</b>	
T5S R28E	
E1/16 S22	
E1/16 S27	

Description of corner evidence found:  
None.

Description of monument and accessories | established to perpetuate the original location of this corner:

At the corner point I set a 2 1/2" x 30" alum. pipe with a 2 1/2" alum. cap containing a magnet and marked:

Monument is 25" in the ground.

E1/16 S22  
S27  
PLS 1832  
1988

From the corner:

A Lodgepole Pine, 9" dia.; N100W, 31.1 ft.; marked: E1/16 S22 BT  
Reference monument, a 5/8" x 30" iron rod (rebar) driven 26" in the ground with a 1 1/8" dia. yellow plastic cap marked: PLS 1832  
bears S56°W, 14.4 ft.

BT has blaze and a 6" band painted red, a BT tag, a "Land Survey Monument" sign and an alum. "PLS 1832" washer nailed to the bottom of the blaze. There is a 6' steel fence post with a "Land Survey Monument" sign within 5' of the corner.

Measured to center of BT using steel tape and staff compass. Magnetic declination set at 18 1/4° E.  
September 2, 1988


RECEIVED BY

Morrow County Surveyor

Date 11/18/88

Rec'd By LSHK

No. D 874K

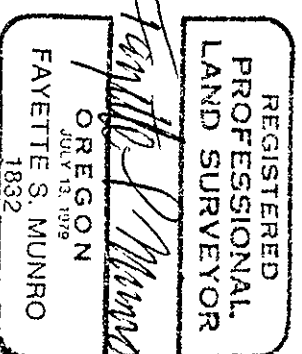

Office of..... County of.....  
State of..... I hereby certify that the within instrument was filed in this office for record on the..... day of....., 19.....

(COUNTY OFFICIAL) by ..... (DEPUTY)