


**CERTIFIED RECORD OF LAND CORNER MONUMENTATION**

R-17

**History of original corner establishment:**

E.W. Sanderson under G.L.O. contract no. 417, dated Aug. 24, 1881, marked a Fir, 8" dia. for the corner, from which:  
 A Fir, 6" dia., N65°W, 17 lks.  
 A Pine, 8" dia., N87°E, 30 lks..  
 A Fir, 12" dia., S35°W, 24 lks.  
 A Fir, 6" dia., S75°E, 36 lks..

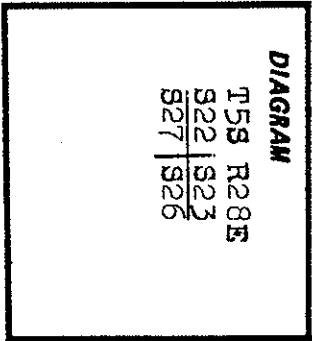

Leonard Carter, Public Land Surveyor, under G.L.O. special instructions, Group No. 228, dated Mar. 23, 1938, did not find the Sanderson corner. At proportionate distance, he set a 2"x 36" iron post with a brass cap marked:  
 From corner: A Lodgepole Pine, 8" dia., N45°E, 12 lks.  
 A Lodgepole Pine, 8" dia., S17°E, 37 lks..  
 A Lodgepole Pine, 11" dia., S14°W, 49 lks.  
 A Lodgepole Pine, 10" dia., N34°W, 64 lks.

**Description of corner evidence found:**

I found a 2" iron pipe with a 2 1/2" brass cap (G.L.O.) marked:  
 From the corner:  
 A Lodgepole pine stump, 13" dia., N34°W, 41.8 ft.;  
 with scribing visible.  
 A Lodgepole pine stump, 12" dia., S18°E, 24.0 ft.;  
 with scribing visible.  
 A Lodgepole pine, 14" dia., down; root hole bears S14°W, approx. 32 ft.  
 Tree has scribing visible.

**Description of monument and accessories | established to perpetuate the**

**original location of this corner:**  
 I marked new BTs:

- A Spruce, 13" dia., N50°E, 87.7 ft.; marked: T55 R28E S23 BT
- A Spruce, 11" dia., S28°E, 47.8 ft.; marked: T55 R28E S26 BT
- A Spruce, 9" dia., S42 3/4°W, 21.4 ft.; marked: T55 R28E S27 BT
- A Spruce, 12" dia., N72°W, 36.6 ft.; marked: T55 R28E S22 BT

BTs have blaze and a 6" band painted red, BT tags and "Land Survey Monument" signs. New BTs have, additionally, alum. "PLS 1832" washers nailed to the bottom of the blaze. There is a 6' steel fence post with a "Land Survey Monument" sign within 5' of the corner.

Measured to center of BTs using steel tape and staff compass. Magnetic declination set at 18 1/2°E.

September 2, 1988


RECEIVED BY

Morrow County Surveyor

Date 11/28

Rec'd by DMH

No. D 974K

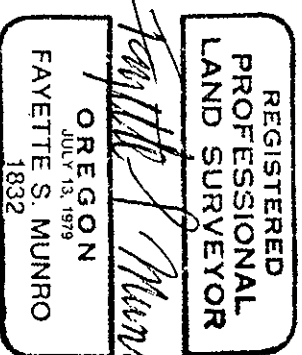

Office of..... County of.....

State of..... I hereby certify that the within instrument was filed in this office

for record on the..... day of....., 19.....

(COUNTY OFFICIAL)

by

(DEPUTY)