


CERTIFIED RECORD OF LAND CORNER MONUMENTATION

R-18

History of original corner establishment:

Insurveyed - subdivided section.

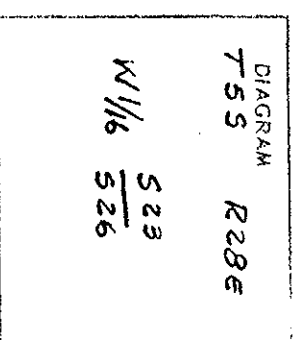

No record of subsequent remonumentation found in County Records.

Description of corner evidence found:

No evidence found.

I set the monument described below midway between the found SW corner and the S 1/4 of Section 23.

Description of monument and accessories I established to perpetuate the original location of this corner

At the position described above, I set a 2 1/2" x 30" iron pipe 21" in ground with brass cap marked as shown:

From which I scribed BIs:

A Lodgepole pine 7" in diam. bears N 69° E 29.1' marked W 1/16 S 23 BT
A tamarack 10" in diam. bears S 15° W 10.4' marked W 1/16 S 26 BT

I nailed a brass washer marked PLS 1638 to BT blazes.


I set steel fence post 6' North and 4' East with signs 54-2 & 4.

I painted a red band around BIs and face of scribe.

I used a steel tape and magnetic compass with 20° East variation and measured a horizontal distance to the center of BIs.

This corner set September 4, 1979. Witness by Dennis Paasch.

See map of survey.

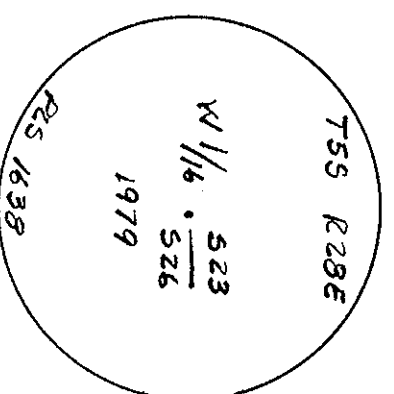

Office of County Surveyor _____ County of Morrow _____
State of Oregon, I hereby certify that the within instrument was filed in this office
for record on the 7th day of September _____ by _____
(COUNTY OFFICIAL) (DEPUTY)

REGISTERED
PROFESSIONAL
LAND SURVEYOR
Terry E. Haasby
OREGON
JULY 14, 19
TERRY E. HAASBY
1638

RECEIVED BY

Morrow County Surveyor

Date 9-7-79

Rec'd By MJD

No. # 252-K

Responding drawing