

CERTIFIED RECORD OF LAND CORNER MONUMENTATION

Refer to: Plat of Stahl 1990 Cadastral Survey  
Section 26, T.5S., R.28E., W.M.

R/2-19

History of original corner establishment:  
No record of previous monumentation.

DIAGRAM  
T5S R28E  
O-N-N 1/64  
S26

Description of corner evidence found:  
None.


Description of monument and accessories | established to perpetuate the  
original location of this corner:  
At the corner point established by measurement, I set a 2 1/2" x 30" alum.  
pipe with a 2 1/2" alum. cap mkd. ;  
The monument is 22" in the ground and surrounded  
by a mound of stone.  
From the corner:  
A Douglas Fir, 20" dia., S64 1/2° E, 108.3 ft. ;  
mkd. ; CNN 1/64 S26 BT  
A Ponderosa Pine, 20" dia., S64 1/2° W, 84.6 ft. ;  
mkd. ; CNN 1/64 S26 BT

O-N-N 1/64  
PLS 1832  
1990

BTs have blaze and a 6" band painted red, BT tags, "Land Survey  
Monument" signs and alum. "PLS 1832" washers nailed to the bottom of  
the blaze. There is a 6' steel fence post with a "Land Survey  
Monument" sign within 5' of the corner.

Measured to center of BTs using steel tape and staff compass. Magnetic  
declination set at 19° E.

July 27, 1990

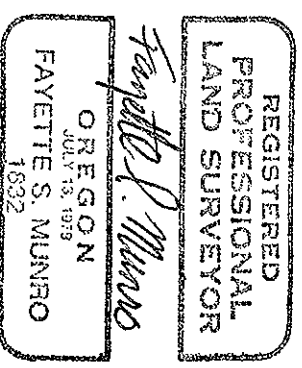

Office of..... County of.....  
State of....., I hereby certify that the within instrument was filed in this office  
for record on the..... day of....., 19.....  
..... by .....  
(COUNTY OFFICIAL) (DEPUTY)

RECEIVED BY  
MORROW COUNTY SHERIFF  
Date 11/91  
Rec'd by DE  
No. C-903-19 R/2-19