

CERTIFIED RECORD OF LAND CORNER MONUMENTATION

Refer to: Plat of Stahl 1990 Cadastral Survey
Section 26, T.5S., R.28E., W.M.

R/2-21

History of original corner establishment:

No record of previous monumentation.

DIAGRAM
T5S R28E
N-N 1/64
S26 | S25

Description of corner evidence found:
None.

Description of monument and accessories | established to perpetuate the original location of this corner:


At the corner point established by measurement, I set a 2 1/2" x 30" alum. pipe with a 2 1/2" alum. cap mkd.;

Monument is 23" in ground.
From the corner:
A Spruce, 14" dia., N48°W, 70.6 ft.;
mkd.: NN 1/64 S26 BT
A Spruce, 16" dia., N190°E, 58.9 ft.;
mkd.: NN 1/64 S25 BT

BTs have blaze and a 6" band painted red, BT tags, "Land Survey Monument" signs and alum. "PLS 1832" washers nailed to the bottom of the blaze. There is a 6' steel fence post with a "Land Survey Monument" sign within 5' of the corner.

Measured to center of BTs using steel tape and staff compass. Magnetic declination set at 190°E.

July 26, 1990

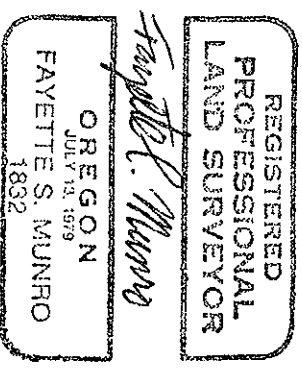

Office of..... County of.....
State of..... I hereby certify that the within instrument was filed in this office
for record on the..... day of....., 19.....
..... by (DEPUTY)
..... (COUNTY OFFICIAL)

Form R6-7100-57 (9/71)

RECEIVED BY

Morrow County Surveyor

Date 1/91

Rec'd by AS

No. C-903 R/2-21