


CERTIFIED RECORD OF LAND CORNER MONUMENTATION

R-21  
Page 1 of 2

History of original corner establishment:  
Edward W. Sanderson under G.L.O. contract no. 417,  
dated Aug. 24, 1881, set a basalt stone 18"x 8"x 5",  
from which:  
Pine, 6" dia., N62°0'E, 20 lks.  
Pine, 6" dia., N45°0'W, 17 lks..  
Pine, 8" dia., S70°0'W, 20 lks.  
Pine, 7" dia., S40°0'E, 6 lks.

(History continued on Page 2 of 2.)

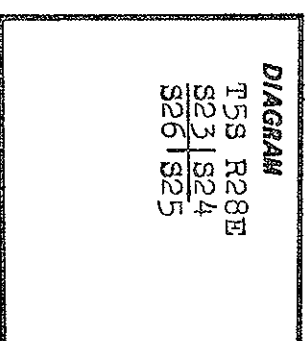

Description of corner evidence found:  
I found a 2" iron pipe with a 2 1/2" brass cap (GIO) mkd.:  
From the corner:  
T5S R28E  
S23|S24  
S26|S25  
1938


A Lodgepole Pine dead and down with scribbing visible; the stump  
of which bears S53°0'E, 39.6 ft.  
A Lodgepole Pine snag, 13" dia., N70°0'E, 48.1 ft.;;  
with scribbing visible.  
A Lodgepole Pine stump, approx. 12" dia., N54°0'W, 8.2 ft.;;  
stump is low cut with no scribbing visible.  
Mound of stone, west, approx. 2 ft..

Description of monument and accessories | established to perpetuate the  
original location of this corner:  
I marked new BTS:

A Lodgepole Pine, 9" dia., N54°10'W, 43.7 ft.;; mkd.;; T5S R28E S23 BT  
A Lodgepole Pine, 7" dia., N21°10'E, 120.9 ft.;; mkd.;; T5S R28E S24 BT  
A Western Larch, 13" dia., S25°0'E, 110.0 ft.;; mkd.;; T5S R28E S25 BT  
A Western Larch, 16" dia., S23°0'W, 105.4 ft.;; mkd.;; T5S R28E S26 BT  
BTS have blaze and a 6" band painted red, BT tags and "Land Survey  
Monument" signs. New BTS have, additionally, alum. "PLS 1832" washers  
nailed to the bottom of the blaze. There is a 6' steel fence post  
with a "Land Survey Monument" sign within 5' of the corner.

Measured to center of BTS using steel tape and staff compass. Magnetic  
declination set at 180E..

July 26, 1990

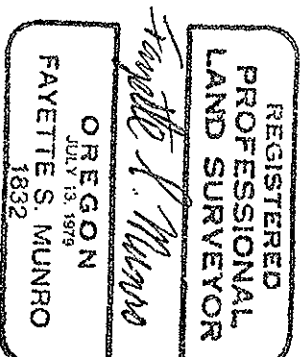

Office of..... County of.....  
State of....., I hereby certify that the within instrument was filed in this office  
for record on the..... day of....., 19.....

by.....  
(COUNTY OFFICIAL) RECEIVED BY (DEPUTY)

Form R6-7100-57 (9/71)

Morrow County Surveyor

Date 1/9/91

Rec'd By *MS*

No. *C-903 R-21*  
(1 of 2)