


History of original corner establishment:

Leonard Carter, Public Land Surveyor, under G.L.O. Special Instructions, Group No. 228, dated Mar. 23, 1938, found a basalt stone 16"x 9"x 4" firmly set. At the corner point he set an iron post 3' long, 2" dia. with a brass cap mkd.:

S23|S24
S26|S25
1938

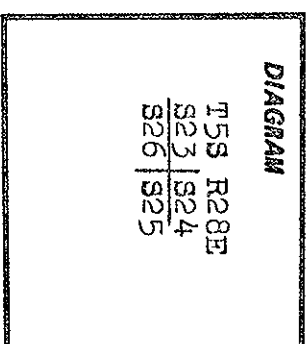


He marked new BTs:

- A Lodgepole Pine, 10" dia., N69°E, 72 lks.
- A Lodgepole Pine, 8" dia., S53°E, 60 lks.
- A Lodgepole Pine, 10" dia., S72°W, 73 lks.
- A Lodgepole Pine, 7" dia., N54°W, 14 lks.

Description of corner evidence found:

Description of monument and accessories I established to perpetuate the original location of this corner:

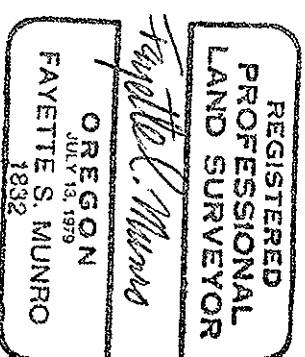

Office of..... County of.....
State of..... I hereby certify that the within instrument was filed in this office
for record on the..... day of....., 19.....

..... by
(COUNTY OFFICIAL) (DEPUTY)

Form R6-7100-57 (9/71)

RECEIVED BY
Morrow County Surveyor

Date 1/9/1
Rec'd By DS
No. 0-903 R-21
(2 of 2)