


CERTIFIED RECORD OF LAND CORNER MONUMENTATION

P-9

History of original corner establishment:

Corner originally established 1882 under Contract Survey No. 417, dated 1881.

Corner re-established by Dependent Resurvey authorized 1938 and approved Feb. 21, 1941.

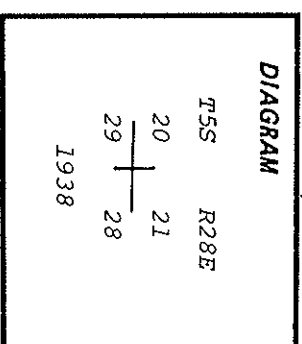

Description of corner evidence found:

2 inch iron pipe with 2 1/2 inch brass cap, marked as shown above,
From which---

A 28" Doug Fir, alive and standing but with top gone, bears N 16° E (record N 14° E) 91.3' (record), blaze healed but scar visible.

A 28" Doug Fir, alive and standing, bears S 17° E (record S 20° E) 19.6' (record), blaze healed but scar visible.

A 14" Pine, dead and standing, bears S 18° W (record S 13° W) 32.1' (record), scribling T55 R28E S29 BT legible.

A 22" White Fir, alive and standing, bears N 32° W (record N 33° W) 142.7' (record 143.2'), blaze healed, scar visible.

Description of monument and accessories | established to perpetuate the original location of this corner:

From Corner location as found and as described above,

A new Bearing Tree, A 14" Doug Fir, bears N 39° E, a distance of 140.2 feet, which I marked T55 R28E S21 BT.

A new Bearing Tree, an 8" White Fir, bears S 29° W, a distance of 38.1 feet, which I marked T55 R28E S29 BT.

Attached USFS signs, 54-3 and 54-4 to all Bearing Trees, and a brass tag marked R.L.S. 1024 to new trees, and painted blazes and a 6" wide band of fluorescent red around trunks.

Set a 6' steel fence post 5' West of corner and attached USFS sign 54-4.

Added a mound of stone around original monument.

REGISTERED
 PROFESSIONAL
 LAND SURVEYOR
Thomas F. Upton
 OREGON
 FEBRUARY 14, 1975
 THOMAS F. UPTON
 1934

Thomas F. Upton, Certificate No. R.L.S. 1024

Office of... *Co. Surveyor* County of... *Morrow*
 State of... *Oregon* hereby certify that the within instrument was filed in this office
 for record on the *12th* day of... *January* 19*82*
David H. Krumbein *Martha A. Hughes*
 (COUNTY OFFICIAL) (DEPUTY)

Form R6-7100-57 (9/71)

RECEIVED BY
Morrow County Surveyor
 ☆ GPO-798-276

Date shown on *12, 1982*
 Rec'd by *M. Hughes*
 No. *410-K*
 Ret. d/wa. No. *C-460-K*