

CERTIFIED RECORD OF LAND CORNER MONUMENTATION

T-17

DIAGRAM

T59 R28E
S27 1/4
S27 1 S26

History of original corner establishment:
Edward W. Sanderson under G.L.O. contract no. 417, 6"
dated Aug. 24, 1881, set a basalt stone 12"x 12"x 6"
mkd. 1/4 on W. face from which:
A Fir, 24" dia., S40°W, 25 lks.
A Fir, 18" dia., S35°E, 22 lks.

Leonard Carter, Public Land Surveyor, under G.L.O.
Special Instructions, Group No. 228, dated Mar. 23,
1938, found a sandstone 12"x 12"x 8" firmly set,
mkd. 1/4 on W. face. At the corner point he set an iron post 3' long,
1" dia., with a brass cap mkd. :
He marked new BTS:
A Yellow Pine, 26" dia., S34°E, 21 lks.
A Douglas Fir, 31" dia., S42°W, 101 lks.

Description of corner evidence found:

- I found a 1" iron pipe bent over with a 2 1/2" brass cap (GLO) mkd. :
I straightened the pipe. From the corner:
A Ponderosa Pine, 30", S34°E, 13.9 ft. ;
with healed blaze. S27 1 S26
1938
- A Douglas Fir snag, 30", S42°W, 66.7 ft. ;
with healed blaze.


Description of monument and accessories I established to perpetuate the original location of this corner:

- I marked new BTS:
A Ponderosa Pine, 16" dia., S64°W, 40.2 ft. ; mkd. : 1/4 S27 BT
A Douglas Fir, 15" dia., N73 3/4°W, 66.1 ft. ; mkd. : 1/4 S27 BT
A Ponderosa Pine, 16" dia., N38°E, 24.2 ft. ; mkd. : 1/4 S26 BT

BTS have blaze and a 6" band painted red, BT tags and "Land Survey Monument" signs. New BTS have, additionally, alum. "PLS 1832" washers nailed to the bottom of the blaze. There is a 6' steel fence post with a "Land Survey Monument" sign within 5' of the corner.

Measured to center of BTS using steel tape and staff compass. Magnetic declination set at 20°E.

July 27, 1990

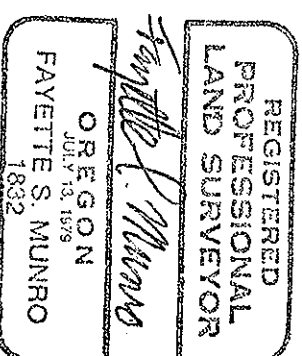

Office of..... County of.....
 State of....., I hereby certify that the within instrument was filed in this office
 for record on the..... day of....., 19.....
 (COUNTY OFFICIAL) by (DEPUTY)

Form RS-7100-57 (9/71)

RECEIVED BY

Morrow County Surveyor

Date 11/91

Rec'd BY [Signature]

No. C-903 T-17