

CERTIFIED RECORD OF LAND CORNER MONUMENTATION

Refer to: Plat of Stahl 1990 Cadastral Survey
Section 26, T5S., R.28E., W.M.

T-19

History of original corner establishment:
No record of previous monumentation.

DIAGRAM
T5S R28E
0¼ S26

Description of corner evidence found:
None.


Description of monument and accessories I established to perpetuate the original location of this corner:

At the corner point established by measurement, I set a 2½" x 30" alum. pipe with a 2½" alum. cap mkd.:
Monument is 15" in the ground and surrounded by
a mound of stone. From the corner:
A Ponderosa Pine, 17" dia., N81½°E, 12.8 ft.;
T5S R28E
0¼ S26
PLS 1832
1990

mkd.: 0¼ S26 BT
A Douglas Fir, 13" dia., S54°E, 47.0 ft.; mkd.: 0¼ S26 BT
A Douglas Fir, 8" dia., S43°W, 71.8 ft.; mkd.: 0¼ S26 BT
A Ponderosa Pine, 6", N71½°W, 52.6 ft.; mkd.: 0¼ S26 BT
BTs have blaze and a 6" band painted red, BT tags, "Land Survey Monument" signs and alum. "PLS 1832" washers nailed to the bottom of the blaze. There is a 6' steel fence post with a "Land Survey Monument" sign within 5' of the corner.

Measured to center of BTs using steel tape and staff compass. Magnetic declination set at 190E.

July 27, 1990

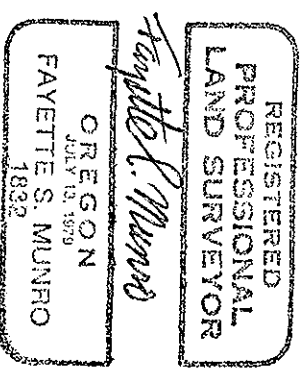

Office of..... County of.....
State of..... I hereby certify that the within instrument was filed in this office
for record on the..... day of....., 19.....
..... by (DEPUTY)
(COUNTY OFFICIAL)

Form R6-7100-57 (9/71)

RECEIVED BY
Morrow County Surveyor

Date 7/27
Rec'd By [Signature]
No. 0-903 T-19