


CERTIFIED RECORD OF LAND CORNER MONUMENTATION

T-21

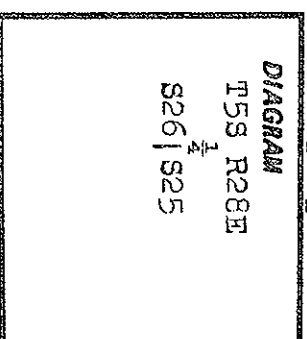

History of original corner establishment:
 Edward W. Sanderson under G.L.O. contract no. 417, dated Aug. 24, 1881, set a basalt stone 15" x 12" x 8" wkd. 1/2 on W. face from which:
 A Fir, 16" dia., N60°W, 14 lks.
 A Pine, 6" dia., S25°E, 15 lks.

Leonard Carter, Public Land Surveyor, under G.L.O. Special Instructions, Group No. 228, dated Mar. 23, 1938, found a sandstone 14" x 10" x 5" firmly set, wkd. 1/4 on W. face. At the corner point he set an iron post 3' long, 1" dia. with a brass cap wkd.:

S26 1/2 S25
1938

From the corner:
 A Douglas Fir, 20" dia., N62°W, 14 lks.; with healed blaze. (Old BT)
 A Douglas Fir, 8" dia., S75°E, 21 lks.; (New BT)

Description of corner evidence found:

I found a 1" iron pipe with a 2 1/2" brass cap (GIO) wkd.: S26 1/2 S25
 Monument is surrounded by a mound of stone. 1938
 From the corner:

A Douglas Fir, 14" dia., S73 1/2°E, 13.4 ft.; with healed blaze.
 A Douglas Fir, 19" dia., N62°W, 9.2 ft.; with healed blaze.


Description of monument and accessories established to perpetuate the original location of this corner:

I marked a new BT:
 A Western Larch, 15" dia., N54 1/4°E, 20.2 ft.; wkd.: 1/4 S25 BT
 I drove a 6' steel fence post, S70°W, 4.9 ft. and attached a "Land Survey Monument" sign.

BTs have blaze and a 6" band painted red, BT tags and "Land Survey Monument" signs. New BT has, additionally, an aluminum "PLS 1832" washer nailed to the bottom of the blaze.

Measured to center of BTs using steel tape and staff compass. Magnetic declination set at 180E.

July 28, 1990

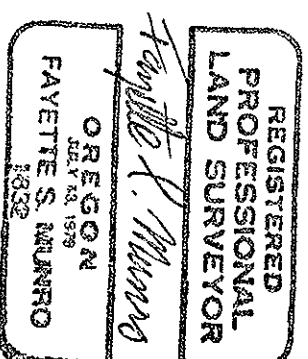

Office of..... County of.....
 State of....., I hereby certify that the within instrument was filed in this office
 for record on the..... day of....., 19.....

..... by.....
 (COUNTY OFFICIAL) RECEIVED BY (DEPUTY)

Form R6-7100-57 (9/71)

Morrow County Surveyor

Date 11/91

Rec'd By 108

No. 0-903 T-21