


CERTIFIED RECORD OF LAND CORNER MONUMENTATION

History of original corner establishment:

This corner was never established on the original survey. The corner was established in error by LS 1106 in 1979.

This corner certificate corrects the corner monument and supercedes the certificate for 1979.

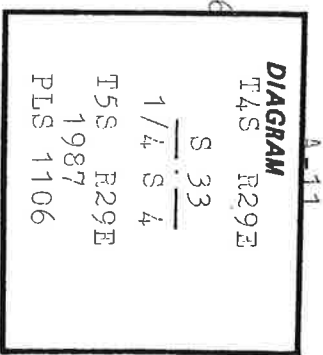

Description of corner evidence found:

Found monument set in error in 1979.

Description of monument and accessories | established to perpetuate the original location of this corner:

Moved 1979 monument to proper position, a move of $S89^{\circ}37'15.2''W-9.70'$. The 1979 monument, a 3" brass cap on $2\frac{1}{2}''$ by 30" galv. iron pipe was set 6" below ground surface on the edge of a dirt road. Cap marked as shown in corner diagram.

Used bearing trees marked in 1979:

A 15" western larch bears $S51^{\circ}E-46.7'$ with scribing 1/4 S4 BT-BT visible on partly healed double blaze.
A 13" western larch bears $S20\frac{1}{2}^{\circ}W-41.1'$ with scribing 1/4 S4 BT-BT visible on partly healed double blaze.
Lower blaze of each bearing tree has a brass washer stamped PLS 1106 nailed to face of blaze.

Attached sign 54-3 and 54-4 to each bearing tree and painted face of blaze and a 6" red band around each bearing tree.

Set steel fence post 3.8' west of corner and attached sign 54-2 and 54-4.

Compass declination- 19° East.

This corner was established on September 25, 1987.

REGISTERED
PROFESSIONAL
LAND SURVEYOR

Will R. Wells

OREGON
JULY 22, 1977
WILLIAM R. WELLS
1106

Office of County Surveyor County of Morrow
 State of Oregon
 for record on the 15th day of October, 1987
David H. Wells by (DEPUTY)
 (COUNTY OFFICIAL)