


CERTIFIED RECORD OF LAND CORNER MONUMENTATION

Index No. A-11

History of original corner establishment:

Corner not previously established.

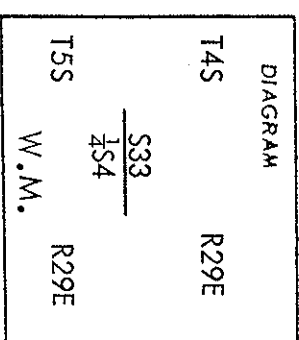

No record of subsequent remonumentation found in County Records .
 Description of corner evidence found:

None.

SUPERCEDED
 SEE 1987
 A-11

Description of monument and accessories I established to perpetuate the original location of this corner

At the corner position a 2 inch by 30 inch iron pipe, with brass cap marked as shown, was set 36 inches in the ground.

Set steel fence posts on section line south and west of corner and attached signs 54-2 and 54-9.

Established 2 new BT's:

A 14" tamarack bears S 33° W, 45.8 feet scribed 1/4 S4 BT.

A 15" tamarack bears S 42 1/2° E, 39.8 feet, scribed 1/4 S4 BT.

New BT's have a lower blaze scribed BT with a brass washer stamped PLS 1106 nailed flush.

Attached signs 54-3 and 54-4 and painted a red ring around all BT's.


Used steel tape and magnetic compass with 19 1/2° east declination. Measured to center of Bts.

See map of survey .

This corner set August 28, 1979.

Witnesses: Greg Flowers, LSIT
 B. J. Reynolds

REGISTERED PROFESSIONAL LAND SURVEYOR
<i>William R. Wells</i>
OREGON JULY 22, 1977 WILLIAM R. WELLS 1106

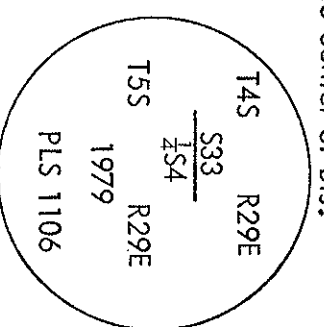

Office of County Surveyor Morrow County of Morrow
 State of Oregon, I hereby certify that the within instrument was filed in this office
 for record on the day of by (DEPUTY)
 (COUNTY OFFICIAL)

RECEIVED BY

Morrow County Surveyor

Date October 16, 1979

Rec'd By M. Murphy

No. 255-H