CERTIFIED RECORD OF LAND CORNER MONUMENTATION

History of original corner establishment:

Corner established by Frank W. Campbell in 1883 under Contract No. 468.
1883 RECORD:
87.26 Intersect N. boundary of Twp at cor. to secs. 5 & 6 which is a post 4' long 4 ins. square firmly set in ground marked: T5S, S5 on SE R29E, S6 on SW.
Faces with 5 notches on E & 1 notch on W edges from which:
A pine 10" dia. bears S 70° E., 30 lks. mkd. T5S R29E S5 BT.
A pine 10" dia. bears S. 30° W., 70 lks. mkd. T5S R29E, S6 BT.
1938 GLO RECORD: Point for cor. of secs. 5 and 6 only, as determined by reference to the record bearing and distance from the original SE. bearing tree.
At point of corner, Set an iron post, 3 ft. long, 2 ins. diam. 27 ins. in the ground, for cor. of secs. 5 and 6 only, with brass cap marked:

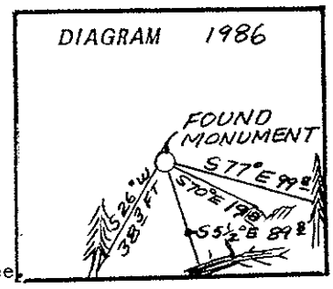

T4S R29E
S32
S6 | S5
T5S | R29E
1938

from which

A dead lodgepole pine, 12 ins. diam., bears S.70°E., 30 lks. dist. mkd. T5S R29E S5 (Old B.T.)
A tamarack, 17 ins. diam., bears S. 5½°E., 136 lks. dist., mkd. T5S R29E S5 BT (New B.T.)
A fir, 10 ins. diam., bears S.26°W., 58 lks. dist., mkd. T5S R29E S6 BT (New B.T.)
Raise a mound of stone, 2 ft. base, 2 ft. high, S of cor.

Description of corner evidence found:

Found 2½ inch G.L.O. brass cap 9 inches above ground

Marked

T4S R29E
S32
S6 | S5
T5S R29E
1938

- Root hole for L.P. pine bears S70°E. 19.8 feet
- Dead, fallen larch bears S5½°E 89.8 feet (face down)
- 21 inches Doug fir bears S26°W 38.3 feet healed face

Corner falls approximately 300 feet south of road 170

Description of monument and accessories I established to perpetuate the original location of this corner: 1986

Build 2 foot diameter mound of stone around corner.

15 inch larch bears S77°E 99.8 feet, marked T5S R29E S5 CC BT

54-3, and 54-9 or 54-4 signs on all bearing trees. Trees have red band and blazes are painted red. Brass washer nailed to BT portion of blaze on new bearing trees and on old bearing trees if needed. Steel guard post with 54-9 or 54-4 sign set 0 to 6 feet from corner. Distance measured in horizontal feet to center of tree. Bearings measured with magnetic compass, 20° East declination.

CERTIFICATION

I, Ken E. Jenkins
certify the information shown herein is true and correct.

Signature of Ground Party Chief

I, Thomas M. Hansen
certify that the field work performed by me or under my direction represents work performed

Signature of Surveyor & Seal

Date 7-86 JUNE 19, 1986 Reg. No. PLS 1058

Employer PROFESSIONAL CONSULTANTS

Office of Surveyor County of Morrow
State of Oregon, I hereby certify that the within instrument was filed in this office for record on the ..... day of November, 19 86
David H. Klein by .....
(COUNTY OFFICIAL) (DEPUTY)

Form R6-7100-57 (9/71)

GPO—798-276