


CERTIFIED RECORD OF LAND CORNER MONUMENTATION

Index No. A-7

History of original corner establishment:

Corner not previously established.

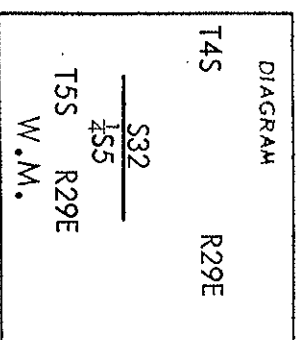

No record of subsequent remonumentation found in County Records .  
 Description of corner evidence found:

A 15" down ponderosa pine with blaze bears N 11° W, 3.2 ft (probable line reference tree).  
 A 20½" standing dead red fir with blaze bears N 85° E, 13.8 ft (probable line reference tree).  
 This corner was established by proportionate measure along the township line.

Description of monument and accessories established to perpetuate the original location of this corner

At the corner position a 2 inch by 30 inch iron pipe, with brass cap marked as shown, was set 26 inches in the ground and surrounded with a mound of stones to the cap.

Set steel fence post on township line by corner and attached sign 54-9.

Established 2 new BT's:

A 14½" red fir bears S 36½° E, 54.4 feet scribed ¼ S5 BT.

A 15½" red fir bears S 25° W, 65.8 feet scribed ¼ S5 BT.

New BT's have a lower blaze scribed BT with a brass washer stamped PLS 1106 nailed flush.


Attached signs 54-3 and 54-4 and painted a red ring around all BT's.

Used steel tape and magnetic compass with 19½° east declination. Measured to center of Bts.  
 See map of survey.

This corner set August 23, 1979.

Witnesses: R. D. English  
 B. J. Reynolds

REGISTERED PROFESSIONAL LAND SURVEYOR
<i>William R. Wells</i> OREGON JULY 22, 1977 WILLIAM R. WELLS 1106

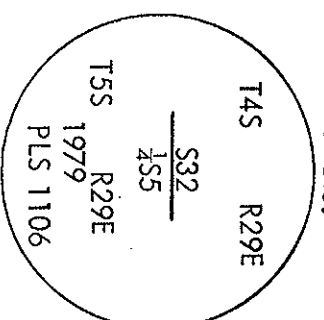

Office of County Surveyor Morrow County of Morrow  
 State of Oregon, I hereby certify that the within instrument was filed in this office  
 for record on the        day of        by        (DEPUTY)  
 (COUNTY OFFICIAL)

**RECEIVED BY**

**Morrow County Surveyor**

Date October 16, 1979

Rec'd By M. Bluyher

No. 255-H