


CERTIFIED RECORD OF LAND CORNER MONUMENTATION

755, R29E

Index No. A-8

History of original corner establishment:

Corner not previously established.

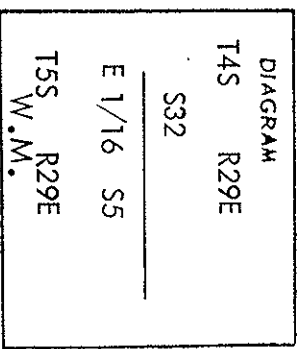

No record of subsequent remonumentation found in County Records .  
Description of corner evidence found:

None.

Description of monument and accessories established to perpetuate the original location of this corner

At the corner position a 2 inch by 30 inch iron pipe, with brass cap marked as shown, was set 29 inches in the ground.

Set steel fence post on township line by corner and attached sign 54-9.

Established 2 bearing trees:

A 6½" tamarack bears S 10½° E, 43.0 feet scribed E 1/16 S 5 BT.

An 8" lodgepole pine bears S 80° W, 24.6 feet scribed E 1/16 S 5 BT.

New BT's have a lower blaze scribed BT with a brass washer stamped PLS 1106 nailed flush.

Attached signs 54-3 and 54-4 to all BT's and painted red ring around the trees above upper blaze.

Location poster is located on North end of cabin S 47° E, 220' from corner.

Used steel tape and magnetic compass with 19½° east declination. Measured to center of Bts.

See map of survey .

This corner set August 23, 1979


REGISTERED  
PROFESSIONAL  
LAND SURVEYOR

Witnesses: R. D. English

B. J. Reynolds

*Willie R. Wells*

OREGON  
JULY 22, 1977  
WILLIAM R. WELLS  
1106

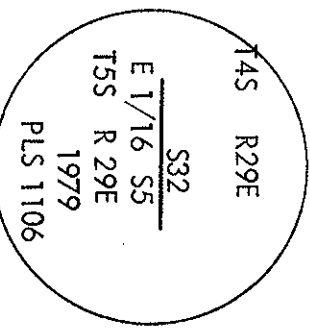

Office of County Surveyor Morrow County of Morrow

State of Oregon, I hereby certify that the within instrument was filed in this office

for record on the day of

(COUNTY OFFICIAL) by (DEPUTY)

RECEIVED BY

Morrow County Surveyor

Date October 16, 1979

Rec'd By M. Wheeler

No. 255-4