


CERTIFIED RECORD OF LAND CORNER MONUMENTATION

T55, R29E

History of original corner establishment:

This corner incorrectly established in 1979 by PLS 1106

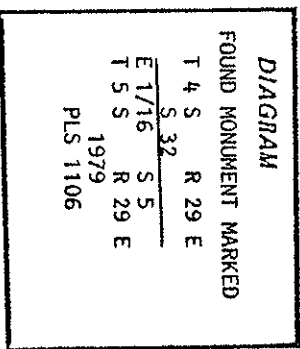

Description of corner evidence found:

Found 3 inch brass cap 2 inches above ground.

NOTE: This corner set at mid-point using incorrectly proportioned 1/4 corner by PLS 1106, 1979. This corner therefore; is not accepted.

These accessories, to monument by 1106, not accepted.

- 8 inch larch bears S, 10.5° E., 43.2 feet marked: E 1/16 S5 BT
- Dead 9 inch lodgepole pine bears S, 80° W., 24.6 feet marked: E 1/16 S5 BT
- 14 inch larch bears N, 87° W., 81.5 feet marked: E 1/16 S5 BT
- (14 inch larch marked this survey)

Description of monument and accessories established to perpetuate the original location of this corner:

At a position mid-way between found NE corner section 5 and N 1/4 Section 5, set this survey, set 3-1/4 inch PCI aluminum cap on 2-1/2 x 30 inch aluminum pipe, 26 inches in the ground

T 4 S R 29 E  
E 1/16 S 5  
T 5 S R 29 E

PLS 1058  
1986

NOTE: These accessories to aluminum cap set 1986  
8 inch LP pine bears S, 76° E., 51.3 feet marked: X BT  
7 inch larch bears S, 04° E., 24.7 feet marked: X BT  
Brass cap by PLS 1106 bears N, 89° 57' 02" E., 8.17 feet.  
220 feet SE to snow survey house

54-3, and 54-9 or 54-4 signs on all bearing trees. Trees have red band and blazes are painted red. Brass washer nailed to BI portion of blaze on new bearing trees and on old bearing trees if needed. Steel guard post with 54-9 or 54-4 sign set 0 to 6 feet from corner. Distance measured in horizontal feet to center of tree. Bearings measured with magnetic compass, 20° East declination.

CERTIFICATION

I, Ken E. Jenkins  
certify the information shown herein is true and correct.

REGISTERED  
PROFESSIONAL  
LAND SURVEYOR

*Ken E. Jenkins*  
Signature (Ground Party Chief)  
Thomas M. Hanson  
Identify that this Corner Record correctly represents work performed by me or under my direction

OREGON  
JUNE 18, 1976  
THOMAS M. HANSON  
105215

Signature of Surveyor & Seal  
Date: 7-86 Reg. No. PLS 1058  
Employer: PROFESSIONAL CONSULTANTS

Office of Surveyor County of Morrow  
State of Oregon I hereby certify that the within instrument was filed in this office  
for record on the day of November, 1986  
*David A. Kavan*  
(COUNTY OFFICIAL) by (DEPUTY)