


CERTIFIED RECORD OF LAND CORNER MONUMENTATION

Index No. C-11

History of original corner establishment:

Corner not previously established.

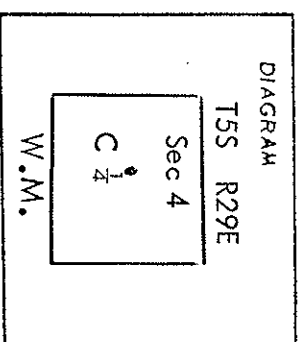

No record of subsequent remonumentation found in County Records .
Description of corner evidence found:

None.

*RECORDED
5/18/81*

Description of monument and accessories I established to perpetuate the original location of this corner The corner falls in the base roots of a 13 1/2" tamarack.
 At a point S 4° 06' E - 2.04 Feet from the corner position, a 2 inch by 30 inch iron pipe, with brass cap marked as shown, was set 20 inches in the ground and surrounded with a mound of stones to the cap. (this is a witness corner)
 Set steel fence posts north and west of corner and attached signs 54-2 and 54-9.
 Established 2 new BT's:
 A 13 1/2" tamarack bears N 45° E, 1.7 feet scribed C 1/4 S4 BT. (these trees reference the witness corner)
 A 9 1/2" red fir bears S 24 1/2° W, 28.2 feet scribed C 1/4 S4 BT.
 New BT's have a lower blaze scribed BT with a brass washer stamped PLS 1106 nailed flush.
 Attached signs 54-3 and 54-4 and painted a red ring around all BT's.
 Location poster located on west side of Road S415, 0.6 mile ± from intersection with Road S53.
 Corner is 230' ± west of location poster.

Used steel tape and magnetic compass with 19 1/2° east declination. Measured to center of Bts.
See map of survey.

This corner set October 4, 1979

Witnesses: Greg Flowers, LSIT

D. Amort

B. J. Reynolds

REGISTERED
PROFESSIONAL
LAND SURVEYOR

William R Wells

OREGON
JULY 22, 1977
WILLIAM R. WELLS
1106

T5S R29E
C 1/4 S4
W.C. 2.04
1979
PLS 1106

Office of: County Surveyor County of Morrow
 State of Oregon, I hereby certify that the within instrument was filed in this office
 for record on the day of
 (COUNTY OFFICIAL) by (DEPUTY)

RECEIVED BY

Morrow County Surveyor

Date October 16, 1979

Rec'd By M. Hughes

No. 255-4