


CERTIFIED RECORD OF LAND CORNER MONUMENTATION

Index No. C-13

History of original corner establishment:

This corner was originally established by Frank W. Campbell under Contract No. 468 dated April 12, 1883. The notes state that at the corner a marked tamarack post 3' long 3" square was set 24" in the ground for corner from which:
 A 10" tamarack bears S 35° W 6 Lks (4.0 ft) marked $\frac{1}{4}$ S BT.
 A 15" tamarack bears N 30° E 22 Lks (14.5 ft) marked $\frac{1}{4}$ S BT.

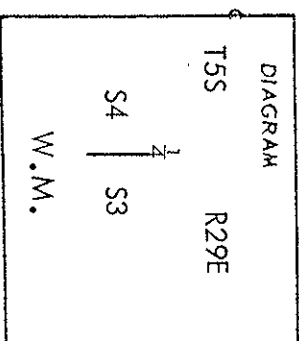

No record of subsequent remonumentation found in County Records .
Description of corner evidence found:

None. Corner re-established by survey.

*Superseded
See C-13*

Description of monument and accessories established to perpetuate the original location of this corner

At the corner position a 2 inch by 30 inch iron pipe, with brass cap marked as shown, was set 28 inches in the ground.

Set steel fence post on section line south of corner and attached sign 54-4.

Established 2 new BT's:

A 6 $\frac{1}{2}$ " red fir bears S 30° E, 30.8 feet scribed $\frac{1}{4}$ S 3 BT.

A 7 $\frac{1}{2}$ " red fir bears S 31 $\frac{1}{2}$ ° W, 23.2 feet scribed $\frac{1}{4}$ S 4 BT.

New BT's have a lower blaze scribed BT with a brass washer stamped PLS 1106 nailed flush.

Attached signs 54-3 and 54-4 and painted a red ring around all BT's.

Used steel tape and magnetic compass with 19 $\frac{1}{2}$ ° east declination. Measured to center of Bts.

See map of survey.


This corner set October 3, 1979

- Witnesses:
- D. Kaufman PLS
 - G. Flowers LSIT
 - D. Amort
 - B. J. Reynolds

REGISTERED
 PROFESSIONAL
 LAND SURVEYOR

William R. Wells

OREGON
 JULY 22, 1977
 WILLIAM R. WELLS
 1106

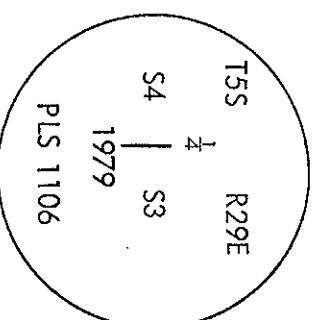

Office of County Surveyor County of Morrow
 State of Oregon, I hereby certify that the within instrument was filed in this office
 for record on the day of by (DEPUTY)
 (COUNTY OFFICIAL)

RECEIVED BY

Morrow County Surveyor

Date October 16, 1979

Rec'd By M. Hughes

No. 255-4