


CERTIFIED RECORD OF LAND CORNER MONUMENTATION

History of original corner establishment:

Corner established 1883 by F. W. Campbell under Contract No. 468
47.26 CH set pine post 3 feet long, 3 inches square, 24 inches in ground.
Marked 1/4 S on West Face

From which:
6 inch pine bears S. 50° E., 22 lks. marked 1/4 S BT
8 inch pine bears N. 89° W., 12 lks. marked 1/4 S BT

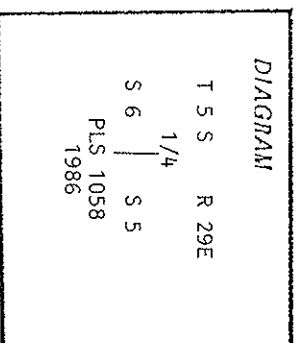

Description of corner evidence found:

No evidence of original corner found.

Description of monument and accessories | established to perpetuate the original location of this corner:

At single proportion position set 3-1/4 inch PCI aluminum cap on 2-1/2 x 30 inch aluminum pipe, 26 inches in the ground. 2 feet mound of stone about corner. Cap marked as shown above.

12 inch white fir bears N. 04° W., 168.0 feet marked 1/4 S 6 BT
8 inch lodgepole pine bears N. 44° E., 17.9 feet marked 1/4 S 5 BT
6 inch lodgepole pine bears N. 76° W., 23.3 feet marked 1/4 S 6 BT

Corner .is. approximately 550 feet North of Highway 53 at Pole Creek.

54-3, and 54-9 or 54-4 signs on all bearing trees. Trees have red band and blazes are painted red. Brass washer nailed to BT portion of blaze on new bearing trees and on old bearing trees if needed. Steel guard post with 54-9 or 54-4 sign set 0 to 6 feet from corner. Distance measured in horizontal feet to center of tree. Bearings measured with magnetic compass, 20° East declination.

CERTIFICATION
I, Ken F. Jenkins

certify the information shown herein is true and correct.

REGISTERED Signaler of Ground Party Chief
PROFESSOR Thomas M. Hanson
LAND Certify that this record correctly represents work performed
by me or under my direction

Signature of Signaler

OREGON
JANUARY 27 1986 Reg. No. PLS 1058
THOMAS M. HANSON
PROFESSIONAL CONSULTANTS
1058 POST

Office of..... Surveyor..... County of.....
State of Oregon..... I hereby certify that the within instrument was filed in this office
for record on the..... day of....., 1986
County Official

(Deputy)

Form R6-7100-57 (9/71)

37 GPO-798-276

Handwritten signature