


CERTIFIED RECORD OF LAND CORNER MONUMENTATION

History of original corner establishment:

None

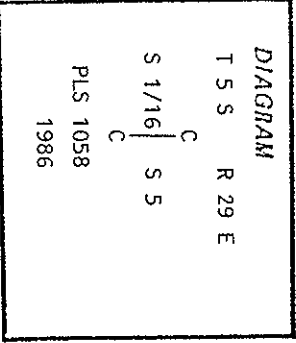

Description of corner evidence found:

None

Description of monument and accessories | established to perpetuate the original location of this corner:

At corner point set 3-1/4 inch PCL aluminum cap on 2-1/2 x 30 inch aluminum pipe, 21 inches in the ground. 3 feet dia. mound of stone about corner. Cap marked as shown above.

8 inch fir bears S. 78° W., 29.4 feet marked: CS 1/16 S 5 BT
12 inch lodgepole pine (Double Bole) bears N. 30° W., 41.3 feet, marked CS 1/16 S 5 BT.

± 100 feet East to Highway 53

54-3, and 54-9 or 54-4 signs on all bearing trees. Trees have red band and blazes are painted red. Brass washer nailed to BT portion of blaze on new bearing trees and on old bearing trees if needed. Steel guard post with 54-9 or 54-4 sign set 0 to 6 feet from corner. Distance measured in horizontal feet to center of tree. Bearings measured with magnetic compass, 20° East declination.

CERTIFICATION

I, Ken E. Jenkins

certify the information shown herein is true and correct.

Ken E. Jenkins
 Registered Professional Surveyor
 by me or under my direction

 State of..... *OREGON* I hereby certify that the within instrument was filed in this office
 for record on the..... day of..... *November*....., 1986
David H. Kline
 (COUNTY OFFICIAL) by (DEPUTY)