


CERTIFIED RECORD OF LAND CORNER MONUMENTATION

Index No. D-9

History of original corner establishment:

Corner not previously established.

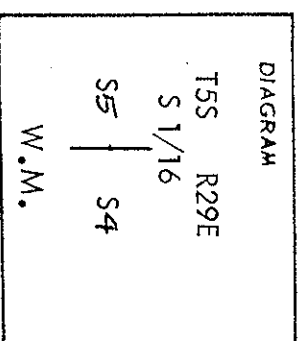

No record of subsequent remonumentation found in County Records .  
Description of corner evidence found:

None .

Description of monument and accessories established to perpetuate the original location of this corner

At the corner position a 2 inch by 30 inch iron pipe, with brass cap marked as shown, was set 28 inches in the ground and surrounded with a mound of stones to the cap .

Set steel fence posts on property line north and west of corner and attached signs 54-2 and 54-9.

Established 2 new BT's:

A 16½" tamarack bears N 75° W, 24.5 feet scribed S 1/16 S5 BT.

A 6" red fir bears S 81½° E, 1.7 feet scribed S 1/16 S4 BT.

New BT's have a lower blaze scribed BT with a brass washer stamped PLS 1106 nailed flush.

Attached signs 54-3 and 54-4 and painted a red ring around all BT's.


Used steel tape and magnetic compass with 19½° east declination . Measured to center of Bts.  
See map of survey.

This corner set August 30, 1979.

Witnesses: D. Kaufman, PLS  
G. Flowers, LSIT  
D. Amort  
B. J. Reynolds

REGISTERED PROFESSIONAL LAND SURVEYOR
---

*William R. Wells*  
OREGON  
JULY 22, 1977  
WILLIAM R. WELLS  
1106

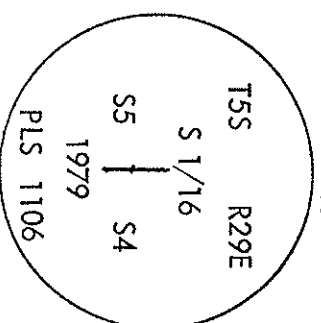

Office of ..... County Surveyor ..... Morrow  
State of Oregon, I hereby certify that the within instrument was filed in this office for record on the ..... day of .....  
(COUNTY OFFICIAL) by ..... (DEPUTY)

RECEIVED BY

Morrow County Surveyor

Date October 16, 1979

Rec'd By M. Hughes

No. 255-4