


CERTIFIED RECORD OF LAND CORNER MONUMENTATION

History of original corner establishment:
Corner established by F.W. Campbell under GLO Contract 468, 1883
1883 GLO record: Set basalt stone 18x18x4 ins, 12 ins. in the ground.
Marked 1/4 on N. face.
From which: -30 pine brs S.15°W. 179 lks mkd: 1/4 S BT
-10" pine brs N.29°W. 26 lks dist. MkD: 1/4 S BT

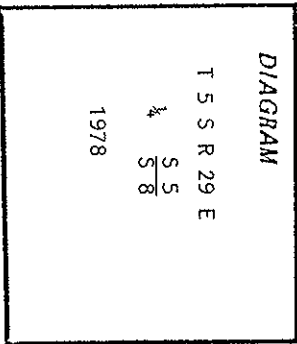

1978 BLM record:
The 1/4 sec. cor. of secs. 5 and 8, monumented with the original basalt stone, 18 x 18 x 4 ins., firmly set 10 ins. in the ground, mkd. 1/4 on N. face, from which the original bearing trees:
A pine, 29 ins. diam., bears N. 29° W., 26 lks. dist., with healed blaze.
A pine, 38 ins. diam., bears S. 15° W., 179 lks. dist., with scribe marks BT visible on open blaze.
At the corner point
Set an iron post, 28 ins. long, 2 1/2 ins. diam., 22 ins. in the ground, with brass cap mkd. as shown.
Deposit corner stone alongside iron post.

Description of corner evidence found:

Found 3 1/4 inch BLM B.C. 7 inches above ground.
Marked: 1/4 S 5
R29E
S 8
1978

- Found 29 inch dead ponderosa pine bears N.26°W. 18.3 feet, healed face
- Found 35 inch dead ponderosa pine bears S.15°W. 115.0 feet, scribe marks visible.

Note: It appears 1978 BLM measured slope distance to face of BTs.

Corner is on southwest facing, open slope approximately 500 feet east to road 180.

Description of monument and accessories | established to perpetuate the original location of this corner:

- 17" ponderosa pine bears S.62°E. 95.6 feet marked: 1/4 S 8 BT
-18" ponderosa pine bears N.05°E. 65.3 feet marked: 1/4 S S BT
-Place brass washers on new and old BTs.

54-3, and 54-9 or 54-4 signs on all bearing trees. Trees have red band and blazes are painted red. Brass washer nailed to BT portion of blaze on new bearing trees and on old bearing trees if needed. Steel guard post with 54-9 or 54-4 sign set 0 to 6 feet from corner. Distance measured in horizontal feet to center of tree. Bearings measured with magnetic compass, 20° East declination.

CERTIFICATION
I, Ken E. Jenkins
certify the information shown herein is true and correct.

THOMAS M. HANSON
Surveyor General
By the designating description
of the monumenting party chief


Office of Surveyor... I hereby certify that the within instrument was filed in this office
State of Oregon... day of... 1986
David H. K... (COUNTY OFFICIAL)