


CERTIFIED RECORD OF LAND CORNER MONUMENTATION

2-19

DIAGRAM

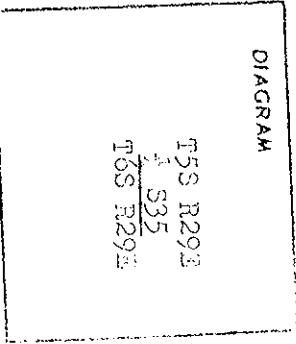

History of original corner establishment:

George S. Pershin under Contract No. 362 dated August 2, 1880:

Set Basalt Stone 12 x 10 x 5 from which

Pine, 20" Dia., BRS. N45°W., 25 lks. Dist.
Pine, 10" Dia., BRS. S12°W., 46 lks. Dist.

Description of corner evidence found:

Found Stone 12 x 12 x 6 with scribed "4" visible from which

Ponderosa Pine, 18" Dia., BRS. S11°W., 29.8 Ft. Dist. with scribing visible on open blaze.

Rotted Pine Stump, BRS. N38 3/4°W., 17.6 Ft. Dist. with no scribing remaining.

Description of monument and accessories established to perpetuate the original location of this corner

Set 32" x 2" flanged iron pipe with brass cap marked:
From which new BTs:

SS
T55 R29E
1/4 S35
1979
PIS 346

Ponderosa Pine, 11" Dia., BRS. N60°W., 27.4 Ft. Dist.
Marked: 1/4 S35 BT


Ponderosa Pine, 7" Dia., BRS. N45°W., 31.1 Ft. Dist.
Marked: 1/4 S35 BT

5' Iron Fence Post with "Attention" sign within 5' of lower blaze.

1979 B.T. have BT tag and printed red stripe, new BTs have brass washer stamped: PIS 346; nailed to lower blaze.

Reared original stone along side iron pipe.

State of Oregon, I hereby certify that the within instrument was filed in this office
for record on the day of
(COUNTY OFFICIAL) by (DEPUTY)

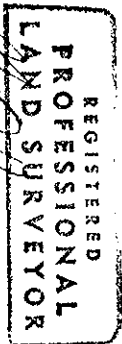

RECEIVED BY

Date 10-23-79
Rec'd By MSJ
No. #28-K