

CERTIFIED RECORD OF LAND CORNER MONUMENTATION


2-21

**History of original corner establishment:**

George S. Pershin under Contract No. 362 dated August 2, 1880:

Set Basalt Stone 12 X 10 X 5 from which

pine, 12" Dia., BRS. 1748<sup>0</sup>W, 41 lks. Dist.  
 pine, 11" Dia., BRS. 1774<sup>0</sup>E, 50 lks. Dist.

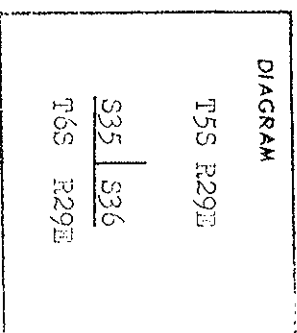

**Description of corner evidence found:**  
 Found no original evidence.

**Description of monument and accessories | established to perpetuate the original location of this corner**

Proportionate point for corner falls in Rd.; unable to bury iron pipe.  
 Set 7" railroad spike 2" below surface of Rd. from which  
 32" 1/2" iron pipe with brass cap marked:  
 BRS. 1750<sup>0</sup>W, 10.0 Ft. Dist.


T55 R29E  
 S35 SC  
 RM  
~~1979 / 2000~~  
 PLS 346

Douglas Fir, 10" Dia., BRS. 1741<sup>0</sup>W, 24.4 Ft. Dist.  
 Marked: T55 R29E S35 SC 3P  
 Ponderosa Pine, 8" Dia., BRS. 1732<sup>0</sup>W, 46.6 Ft. Dist.  
 Marked: T55 R29E S36 SC 3P

6' Iron Fence Post with "Survey Monument" sign within 5' of corner.

111 E.T. have TF tag and painted red stripe, New BRS have brass washer stamped:  
 PLS 346; nailed to lower blaze.

Office of          County Surveyor          County of          MORROW  
 State of          OREGON         , I hereby certify that the within instrument was filed in this office  
 for record on the          day of           
         (COUNTY OFFICIAL) by          (DEPUTY)

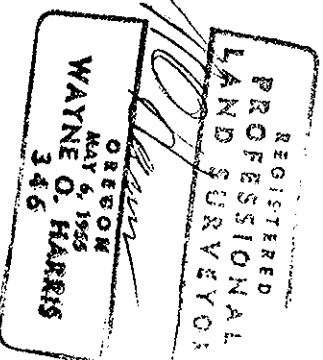

RECEIVED BY

MORROW County Surveyor  
 Date 10-23-79  
 Rec'd By MSJ  
 No. #78-K

*According drawing*