


CERTIFIED RECORD OF LAND CORNER MONUMENTATION

2-23

History of original corner establishment:

George S. Pershin under Contract no. 362  
Dated August 2, 1880  
Set Basalt Stone 16" X 12" X 6" from which  
Pine, 36" Dia., BRS. N120°E., 28 lks. Distance.  
Fir, 9" Dia., BRS. S85°W., 5+ lks. Distance.

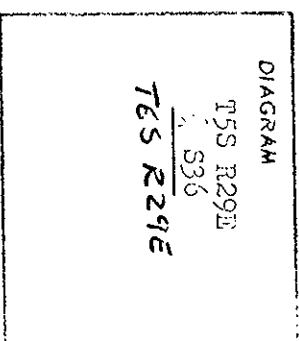

Description of corner evidence found:

Found (BRGS. and DISTS from re-established corner point; original stone is now gone).  
Douglas Fir, 16" Dia., BRS. S84 1/4°W., 35.6 Ft. Distance with scribing visible on open blaze.  
Rotted Stump, 26" Dia., BRS. N20°E., 18.5 Ft. Distance with no scribing remaining.

Description of monument and accessories | established to perpetuate the original location of this corner

Set 32" X 2" flanged iron pipe with brass cap marked:

SC
T5S R299E
S36
1979
PLS 346

From which new BTS

Douglas Fir, 10" Dia., BRS. N27°W., 33.6 Ft. Dist.  
Marked: 1/4" S36 SC BT  
Larch, 11" Dia., BRS. N15 1/2°E., 20.2 Ft. Dist.  
Marked: 1/4" S36 SC BT  
6' Iron Fence Post with "Attention" sign within 5' of Corner

All B.T. have BT tag and painted red strip. New BTS have Brass Washer stamped: PLS 346; nailed to lower blaze.

Office of ..... County Surveyor ..... County of ..... Umatilla .....  
State of Oregon, I hereby certify that the within instrument was filed in this office  
for record on the ..... day of .....  
..... by .....  
(COUNTY OFFICIAL) (DEPUTY)

Form R6-7100-57 (9/71)


RECEIVED BY

County Surveyor

Date 10-17-79

Rec'd By WMS

No. # 228

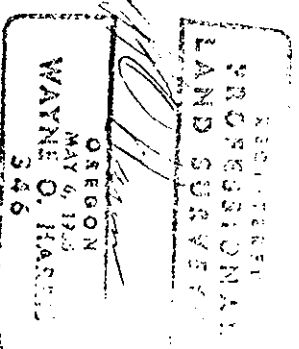

# 369-K