

CERTIFIED RECORD OF LAND CORNER MONUMENTATION


J-17

History of original corner establishment:

Corner originally established by E. W. Sanderson under Contract No. 368, dated Sept. 7, 1880.

Government field notes state:

Set stone 14x10x5 in stone mound for cor. to Secs. 14, 15, 10, 11.

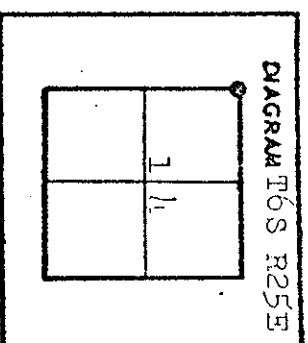

Description of corner evidence found:

Found original corner stone 15"x10"x6" marked with 4 grooves on South face and 2 grooves on East face loosely set in ground. This corner is at the Southeast corner of a rail rock crib supporting a wire fence which runs North and South.


This corner stone is harmoniously related to other known corners in the area. I accept this position for the section corner.

See my recorded Map of Survey dated Oct. 1980.

Description of monument and accessories I established to perpetuate the original location of this corner

At the corner point:
Set a 1 1/2"x30" ironpipe 6" in the ground to bed rock, with brass cap marked as shown:
From which I scribe NEW BEARING TREES:

A pine 17" in diam. bears N. 67° E., 90.2 ft. mkd. T6S R25 E, S11 BT.
A pine 24" in diam. bears N. 17° W., 206.5 ft. mkd. T6S R25 E S10 BT.
No BT's available within limits in Secs. 14 or 15.

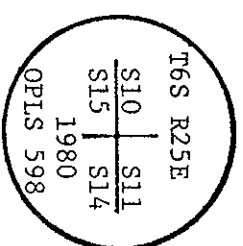

Buried original corner stone East and alongside iron pipe, and surrounded pipe with a mound of stone, 4 ft. base to top of pipe.
Used magnetic compass with 17° East variation and steel tape, measuring to the face of BT blaze.

Done: Oct. 15, 1980.
Witness: G. L. Earl, O.P.L.S.

BRASS CAP
MARKED:

REGISTERED
PROFESSIONAL
LAND SURVEYOR

OREGON
JULY 12, 1963
ROBERT D. BAGGETT
598

Office of Surveyor County of Morrow
State of Oregon , I hereby certify that the within instrument was filed in this office
for record on the 10th day of November, 1980, by
David H. Baggett (COUNTY OFFICIAL) (DEPUTY)

RECEIVED BY
Morrow County Surveyor
Date 11-10-80
Rec'd by M.S.J.
No. # 399-K
Refer to orig no. # 393-K