


CERTIFIED RECORD OF LAND CORNER MONUMENTATION

L-21

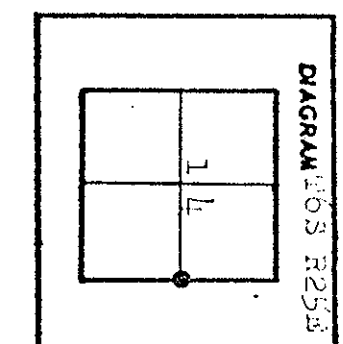

History of original corner establishment:
 Corner originally established by E. W. Sanderson under Contract No. 368, dated Sept. 7, 1880.
 Government field notes state:

Set stone 14x14x6 in. stone mound for ¼ sec. cor. from which
 A tamarack 10" in diam., N. 70° W., 23 lks.
 A fir 12" in diam., East 11 lks.

Description of corner evidence found:

I did not find the original ¼ corner stone, the original bearing trees, or any evidence of its position. The corner position falls in the middle of a logging skid trail. After a diligent search for the corner with no luck, I declare this corner lost and establish the ¼ corner at single proportionate measure between the found NE and SE corners of this section.

See my recorded Map of Survey dated Oct. 1980.
Description of monument and accessories established to perpetuate the original location of this corner

At the corner point:

Set a 1½"x30" iron pipe 26" in the ground with brass cap marked as shown: From which I scribe NEW BEARING TREES:


A Tamarack 18" in diam., bears N. 47° E., 48.7 ft. mkd. ¼ S13 BT.
 A Fir, 15 " in diam. bears West, 38.3 ft. mkd. ¼ S14 BT.

Surrounded pipe with a mound of stone, 3 ft. base, to top of pipe.

Used magnetic compass with 17° East variation and steel tape, measuring to the face of BT blaze.

Done: Oct. 14, 1980.

Witnesses: G. L. Earl, O.P.L.S. and Sid Zinter, Jr., Land owner.

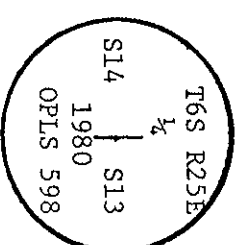

BRASS CAP
 MARKED:

REGISTERED
 PROFESSIONAL
 LAND SURVEYOR

Robert D. Baggett
 OREGON
 JULY 12, 1963
 ROBERT D. BAGGETT
 598

Office of.....SURVEYOR..... County of.....MORROW.....
 State of.....OREGON....., I hereby certify that the within instrument was filed in this office
 for record on the 10 day of.....November.....1980.
David H. Blair
 (COUNTY OFFICIAL) by..... (DEPUTY)

RECEIVED BY
 Morrow County Surveyor
 Date 11-10-80
 Rec'd By M.B.T.
 No. # 396-K

Refer to Aug. 98 # 393-K