

CERTIFIED RECORD OF LAND CORNER MONUMENTATION


N-17

History of original corner establishment:

Corner originally established by E. W. Sanderson under Contract No, 368, dated Sept. 7, 1880.

Government field notes state:

Set stone 14x12x6 in earth mound for corners to Secs. 22, 23, 14, 15.

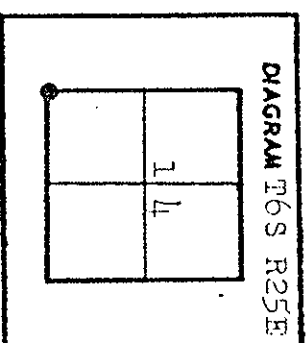

Description of corner evidence found:

I found a basalt stone 13"x10"x7" marked with 3 grooves on South face set in a mound of stone.

This corner is harmoniously related to other known corners in the area. I accept this position for the section corner.


See my recorded Map of Survey dated Oct. 1980.

Description of monument and accessories I established to perpetuate the original location of this corner

At the corner point:
Set a 1½"x30" iron pipe 26" in the ground with brass cap marked as shown:

From which I scribe NEW BEARING TREES:

A pine 25" in diam. bears N. 56° E., 389.0 ft. mkd. T6SR25E S14 BT.
A pine 23" in diam. bears S. 72° E., 183.4 ft. mkd. T6SR25 E. S23 BT.
A double trunked pine 48" in diam., below fork, bears N. 41° W., 329.2 ft. mkd. T6S R25 E. S15 BT.

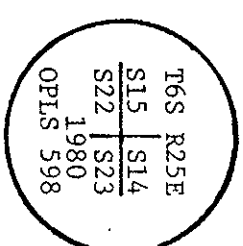

Buried corner stone East and alongside iron pipe and surrounded pipe with mound of stone, 3 ft. base to top of pipe.

Used magnetic compass with 19° E. variation, and a steel tape measuring to the face of BT blaze.

This corner is at corner of remains of old rail fence which ran South and East.

Done: Oct. 17, 1980.
Witness: G. L. Earl, O.P.L.S.

Office of.....SURVEYOR..... County of.....MORROW.....
State of.....Oregon....., I hereby certify that the within instrument was filed in this office
for record on the 19th day of November, 1980.
.....*(Signature)*..... by*(Signature)*.....
(COUNTY OFFICIAL) (DEPUTY)

REGISTERED
PROFESSIONAL
LAND SURVEYOR
(Signature)
OREGON
JULY 12, 1963
ROBERT D. BAGETT
598

BRASS CAP
MARKED.

RECEIVED BY
Morrow County Surveyor
Date 11-10-80
Rec'd By Wm. J. J.
No. # 400-K
Refer to dup no. #393-K