


CERTIFIED RECORD OF LAND CORNER MONUMENTATION

N-21

DIAGRAM T6S R25E

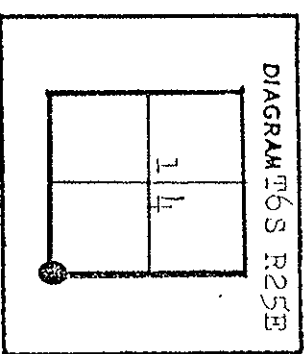

History of original corner establishment:
 Corner originally established by E.W. Sanderson
 under Contract No. 368, dated Sept. 7, 1880.
 Government field notes state:

- Set Stone 14x10x5 in stone mound for cor to Secs. 23, 24, 13, 14 from which
- A Tamarack 15 in diam., S80°W. 80 lks.
- A Pine 6 in diam., S50°E. 30 lks.
- A Pine 6 in diam., N70°E. 9 lks.

Description of corner evidence found:

I found the original corner stone, a basalt stone 14"x10"x5" marked with 3 grooves on one side set in mound of stone.
 from which the ORIGINAL BEARING TREES:
 The stumphole of an uprooted tamarack 21" diam., bears S.80°W., 52.8 ft. mkd. T6SR25E23.
 The remains of a dead and down deteriorating pine bears S.40°E., 24 ft. mkd. T6S S24.
 A standing dead pine 8" diam., bears N.70°E. 6.0 ft. mkd E S13 in blaze that has been opened several years ago.
 See my recorded Map of Survey dated Oct. 1980.

Description of monument and accessories established to perpetuate the original location of this corner

At the corner point:


Chiseled a 6"x6" cross one inch deep in the surface of bed rock.

From which I scribe NEW BEARING TREES:

- A fir 15" diam., bears N20°E., 65.9 ft. marked T6SR25E S13 BT.
- A fir 10" diam., bears S50°E., 62.4 ft. marked T6SR25E S24 BT.
- A fir 11" diam., bears S49°W., 48.3 ft. marked T6SR25E S23 BT.
- A fir 11" diam., bears N27°W., 57.2 ft. marked T6SR25E S14 BT.

Set original corner stone one foot North of chiseled cross and raised a mound of stone around cross.

Used true bearings (Solar Observation) and steel tape, measuring to face of BT blaze.

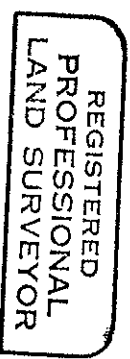

Witness: G.L. Earl, O.P.L.S.

Robert D. Baggett

Office of Surveyor County of Morrow
 State of Oregon, I hereby certify that the within instrument was filed in this office
 for record on the 19 day of Nov., 1980.
David H. Ellis
 (COUNTY OFFICIAL) by (DEPUTY)

RECEIVED BY

Morrow County Surveyor

Date 11-10-80

Rec'd By Wm. J. J.

No. # 394-K

Refer to diary no. # 323-K