


**CERTIFIED RECORD OF LAND CORNER MONUMENTATION**

N-23

DIAGRAM T6S R25E

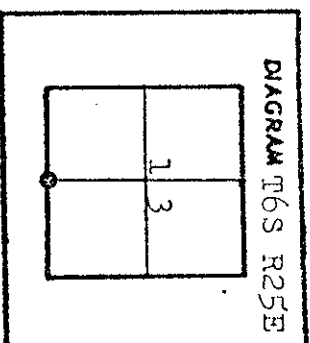

**History of original corner establishment:**

Corner originally established by E. W. Sanderson under Contract No. 368, dated Sept. 7, 1880.

Government field notes state:

Set stone 24x14x6 in stone mound for ¼ cor. from which

A pine 30" in diam., N. 10° E., 22 lks.

A pine 8" in diam., S. 78° E., 18 lks.

**Description of corner evidence found:**

I found original corner stone, a basalt stone 15"x11"x6", laying on its side, marked ¼. This stone had been run over by a bull dozer.

From which an ORIGINAL BEARING TREE:

A pine 31" in diam. bears N. 23° E., 15.0 ft., mkd. ¼S in open blaze.

I did not find any evidence of the other BT. It has probably been destroyed in logging operations.

See my recorded Map of Survey dated Oct. 1980.  
**Description of monument and accessories established to perpetuate the original location of this corner**

At the corner point:

Set a 1½"x30" iron pipe 20" in the ground with brass cap marked as shown.

From which I scribe NEW BEARING TREE:


A red fir 11" in diam. bears S. 57° E., 36.2 ft., mkd. ¼ S24 BT.

Buried original corner stone South and alongside iron pipe and surrounded pipe with a mound of stone, 3 ft. base to top of pipe.

Used magnetic compass with 20° East variation and steel tape, measuring to the face of BT blaze.

Done Oct. 23, 1980.

Witness: G. L. Earl, O.P.L.S. and R. L. Graham, Kinzua Corp.

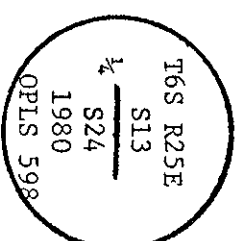

BRASS CAP MARKED.

REGISTERED PROFESSIONAL LAND SURVEYOR

*Robert D. Baggett*  
 OREGON  
 JULY 12, 1963  
 ROBERT D. BAGGETT  
 598

Office of ..... SURVEYOR ..... County of ..... MORROW .....

State of Oregon, I hereby certify that the within instrument was filed in this office for record on the 10 day of November, 1980.

*David A. Walker*  
 (COUNTY OFFICIAL) by ..... (DEPUTY)

RECEIVED BY  
 Morrow County Surveyor  
 Date 11-10-80  
 Rec'd By W.M.D.J.  
 No. # 41D-K  
 refer to deug no. # 393-K