

CERTIFIED RECORD OF LAND CORNER MONUMENTATION

N-25


History of original corner establishment:

Corner originally established by E. W. Sanderson, under Contract No. 368 dated Sept. 7, 1880.

Government field notes state:

Set stone 14x12x7 in stone mound for corner to Secs. 13 and 24, T6S R25 E., from which:

A pine 24" in diam. S. 40° W. 56 lks.
A pine 26" in diam. N. 35° E. 24 lks.

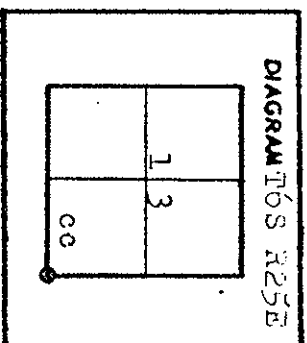

Description of corner evidence found:

I found a basalt stone 14"x12"x7" marked with 3 grooves on North face, 3 grooves on South face, 6 grooves on East face and 6 grooves on West face, firmly set in a mound of stone.
From which the ORIGINAL BEARING TREES:

A pine 20" in diam. bears S. 45° W., 12.9 ft. mkd. 6S R25E S24 in blaze that has been partially opened several years ago. Lower blaze is completely/healed over.
A pine 25" in diam. bears N. 82° W., 27.5 ft. with scribing visible in blaze that is almost healed over. Lower blaze is completely healed over.

The blazes on both of these BTs face the corner stone.


See my recorded Map of Survey dated Oct. 1980.

Description of monument and accessories I established to perpetuate the original location of this corner

I accept the position of the stone as being at the true intersection of the South boundary of Sec. 13 and the Range line for the following reasons:

1. I found the stump hole and the remains of the 18" line tree, still showing the double hack and blaze, 70 feet due South of this closing cor. stone.
2. I cannot find the original SW corner of Sec. 18 due to logging operations disturbing that area.
3. Instead of 2 chains between the closing corner and the SW cor. of Sec. 18 there is about 3 chains as that area is where the blazes face on the original BTs for that corner. However, the bearings and distances are not compatible with those given in the notes.
4. Therefore the only solid evidence of the location of the Original Range line is the line tree as called for.

BRASS CAP
MARKED.

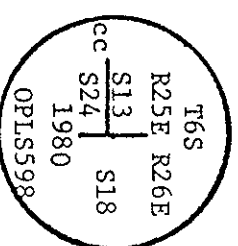

REGISTERED
PROFESSIONAL
LAND SURVEYOR

Robert D. Baggett
ROBERT D. BAGGETT
JULY 12, 1963
598

At the closing-corner:
Set a 1½"x30" iron pipe 24" in the ground with brass cap marked as shown:
Buried original corner stone West and alongside pipe and surrounded pipe with a mound of stone.
Used compass with 20° East variation and steel tape measuring to face of BT Blaze.

State of.....OREGON....., I hereby certify that the within instrument was filed in this office
for record on the 19 day ofNovember, 1980;
David W. Rabin
..... by
(COUNTY OFFICIAL) (DEPUTY)

Done: Oct. 27, 1980.
Witness: G. L. Earl, O.P.L.S.

RECEIVED BY

Morrow County Surveyor

Date 11-10-80

Rec'd by Wm. S. J.

No. # 414-K

Refer to Aug 10 # 393K