

OREGON CORNER RESTORATION FORM

COUNTY: Morrow DATE: 06/24/11

CORNER DESIGNATION: V-21, The Northwest corner of Section 36, Township 6 South, Range 25 East, W.M.

PREVIOUS RENEWALS/SURVEYS ETC: Corner originally established by E. W. Sanderson under Contract No. 368 dated September 7, 1880. Notes state: Set stone 14x14x4 in stone mound for cor. to secs. 25, 26, 35, 36 from which a pine 18 in. dia. bears N 35° W, 16 lks., a juniper 18 in. dia. bears S 68° E, 52 lks.

MONUMENT AND ACCESSORIES FOUND: Found a 14"x14"x4" stone marked with 5 grooves on one edge, loose in a 3' dia. mound of stone. The original live 18" dia. pine bearing tree now 20" in dia. with scribes visible on partly healed blaze bears North 35° West, a distance of 10.6 feet to the face of blaze, and 11.5 feet to the tree centerline. The original live 18" juniper bearing tree now 28" in dia. with scribes visible on open blaze bears South 65° East, a distance of 32.1 feet to the face of blaze, and 32.6 feet to the tree centerline.

MONUMENT MARKING DETAIL:

T6S R25E
S26|S25
S35|S36
2011
PLS 54657

MONUMENT SET: At position of found stone set a 5/8"x24" iron rebar with 2" dia. aluminum cap, 22" in the ground and surround with a mound of stones and earth. The original stone is set on the South side of monument in the new mound. Cap is marked as shown in "Monument Marking Detail".

New accessories:

- A 7" ponderosa pine scribed T6S R25E S25 BT on single blaze bears North 41° East, 50.9 feet to tree centerline.
- A 11" ponderosa pine scribed T6S R25E S35 BT on single blaze bears South 10° West, 35.3 feet to tree centerline.

Attached bearing object signs to all bearing trees. Attached witness sign facing East to the original pine bearing tree in NW quadrant.

LOCATION AND COMMENTS: Corner is located approximately 30' Westerly of a locked gate into private property. The fence runs Southerly and Easterly from the original pine bearing tree in the NW quadrant.


STATE PLANE COORDINATE, NAD 83(CORS96)(EPOCH 2002.00), International Feet:
North = 490627.44
East = 8412183.54

FIRM: Wells Surveying
P.O. Box 1696
Pendleton, OR 97801

COMPASS DECLINATION: 18° East Surveyor's Seal

Witnesses: William R. Wells, PLS

\6S25V21

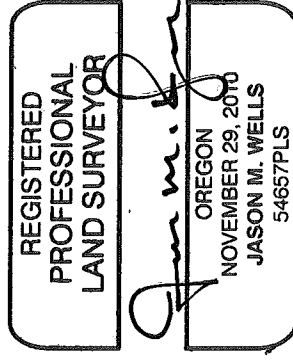

File + Seal 2011

RENEWS: 6/30/12