

V-23

OREGON CORNER RESTORATION FORM

COUNTY: Morrow. DATE: 06/24/11

CORNER DESIGNATION: V-23, The North One-Quarter corner of Section 36, Township 6 South, Range 25 East, W.M..

PREVIOUS RENEWALS/SURVEYS ETC: Corner originally established by E. W. Sanderson under Contract No. 368 dated September 7, 1880. Notes state: Set stone 14x12x8 in stone mound for 1/4 sec. cor. from which a pine 10 in. dia. bears South, 23 lks., a pine 9 in. dia. bears N 65° E, 20 lks.

MONUMENT AND ACCESSORIES FOUND: Found a 14"x11"x6" stone with no marks visible in a 3' dia. mound of stone. A rotted ponderosa pine stub bears North 65° East 13.2 feet with visible scribing on pitched face beside stub. Nothing remains of the original bearing tree South, 23 lks.

MONUMENT MARKING DETAIL:

T6S R25E

- 1 S25
- 4 S36
- 2011

PLS 54657

MONUMENT SET: At position of suspected original stone set a 5/8" x 20" iron rebar with 2" aluminum cap to refusal. Monument cap is at ground level and monument is surround with stones and earth. Cap is marked as shown in "Monument Marking Detail". The corner stone was placed in the new mound, NE of the new monument.

New accessories:

- A 8" ponderosa pine scribed 1/4 S25 BT on single blaze bears North 59° East, 60.4 feet to tree centerline.
- A 11" ponderosa pine scribed 1/4 S36 BT on single blaze bears South 71° East, 89.2 feet to tree centerline.
- A 6" juniper scribed 1/4 S36 BT on single blaze bears South 43° West, 42.6 feet to tree centerline.
- A 10" juniper scribed 1/4 S25 BT on single blaze bears North 03° West, 5.9 feet to tree centerline.

Attached bearing object signs to all new bearing trees. Attached witness sign facing South to the 10" juniper bearing tree.

LOCATION AND COMMENTS: Corner is located 3 feet North of an East-West fence line.


STATE PLANE COORDINATE, NAD 83(CORS96)(EPOCH 2002.00), International Feet:
North = 490715.53
East = 8414846.11

FIRM: Wells Surveying
P.O. Box 1696
Pendleton, OR 97801

COMPASS DECLINATION: 18° East Surveyor's Seal

Witnesses: William R. Wells, PLS

\6S25V23

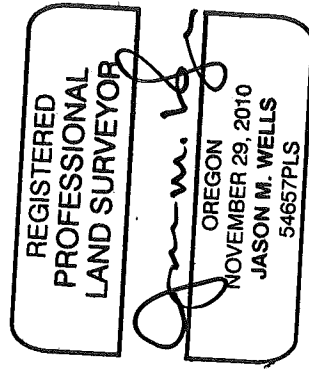

RENEWS: 6/30/12