

V-25

OREGON CORNER RESTORATION FORM

COUNTY: Morrow. DATE: 06/29/11

CORNER DESIGNATION: V-25, The Northeast corner of Section 36, Township 6 South, Range 25 East, W.M..

PREVIOUS RENEWALS/SURVEYS ETC: Corner originally established by E. W. Sanderson under Contract No. 368 dated September 7, 1880. Notes state: Set stone 18x14x10 in stone mound for cor. to secs. 25 and 36. Notes indicate this corner is 240 lks. North of the corner on Range line.

MONUMENT AND ACCESSORIES FOUND: Found a 18"x13"x6" rough stone in a 3' dia. mound of stone with no marks visible. A 32" ponderosa pine with rounded open blaze bears South 86° East, a distance of 18.7 feet to the tree centerline. There are two old "K" tags attached to this tree.

CORNER DIAGRAM:

	T6S	
R25E	R26E	
<u>S25</u>		
S36		

MONUMENT SET: Corner position falls on solid shelf rock. At position of found stone set a "MagNail" with a 3/4" brass washer in a 3/8" drill hole filled with lead, 6" below ground level and surround with mound of stones. Placed corner stone above "MagNail" and laid a railroad spike by the "MagNail" as a memorial.

New accessories:

- A 10" ponderosa pine scribed T6S R25E S25CC BT on single blaze bears North 45° East, 56.4 feet to tree centerline.
- A 6" ponderosa pine scribed T6S R25E S36CC BT on single blaze bears South 23° East, 31.4 feet to tree centerline.
- A 6" juniper scribed T6S R25E S36CC BT on single blaze bears South 49° West, 31.3 feet to tree centerline.
- A 5" ponderosa pine scribed T6S R25E S36CC BT on single blaze bears North 27° West, 67.4 feet to tree centerline

Attached bearing object signs to all new bearing trees. Attached witness sign facing West to the 32" ponderosa pine with "K" tags attached.

LOCATION AND COMMENTS: Corner is located North 66° East 42 feet from a fence corner with fences running South and West.


STATE PLANE COORDINATE, NAD 83(CORS96)(EPOCH 2002.00), International Feet:
North = 490757.07
East = 8417529.42

FIRM: Wells Surveying
P.O. Box 1696
Pendleton, OR 97801

COMPASS DECLINATION: 18° East Surveyor's Seal

Witnesses: William R. Wells, PLS

\\6S25V25

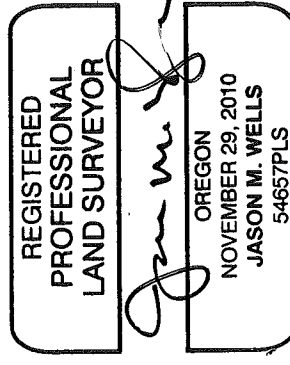

RENEWS: 6/30/12