

X-21

# OREGON CORNER RESTORATION FORM

COUNTY: Morrow. DATE: 06/24/11

CORNER DESIGNATION: X-21, The West One-Quarter corner of Section 36, Township 6 South, Range 25 East, W.M..

PREVIOUS RENEWALS/SURVEYS ETC: Corner originally established by E. W. Sanderson under Contract No. 368 dated September 7, 1880. Notes state: Set stone 14x12x5 in stone mound for 1/4 sec. cor. from which a tamarack 30 in. dia. bears S 30° W, 12 lks., a fir 8 in. dia. bears S 60° E, 22 lks.

MONUMENT AND ACCESSORIES FOUND: Found a 14"x10"x6" set stone marked 1/4 on East face in a small 2' dia. mound of stone. A 28" rotted douglas fir stump bears South 40° East, a distance of 14.5 feet to the tree centerline (record states 8" fir, South 60° East 22 lks.). Nothing remains of the original 30" tamarack bearing tree.

### MONUMENT MARKING DETAIL:

T6S R25E  
1/4  
S35|S36  
2011  
PLS 54657

MONUMENT SET: At position of found stone set a 2 1/2" brass cap on 1 1/4"x30" galvanized iron pipe 23" in the ground and surround with stones and earth. Cap is marked as shown in "Monument Marking Detail". Placed corner stone in mound South of new monument.

### New accessories:

- A 10" Douglas fir scribed 1/4 S36 BT on single blaze bears North 23° East, 14.0 feet to tree centerline.
- A 6" western larch scribed 1/4 S36 BT on single blaze bears South 61° East, 12.3 feet to tree centerline.
- A 9" Douglas fir scribed 1/4 S35 BT on single blaze bears South 38° West, 27.9 feet to tree centerline.
- A 8" Douglas fir scribed 1/4 S35 BT on single blaze bears North 30° West, 37.5 feet to tree centerline.

Attached bearing object signs to all new bearing trees. Attached witness sign facing North to a 15" Douglas fir 13' Southeast of corner.

LOCATION AND COMMENTS: Corner is located 1 foot East of a North-South fence approximately 160' South of a Porter Creek.


STATE PLANE COORDINATE, NAD 83(CORS96)(EPOCH 2002.00), International Feet:  
North = 487946.18  
East = 8412209.13

FIRM: Wells Surveying  
P.O. Box 1696  
Pendleton, OR 97801

COMPASS DECLINATION: 18° East Surveyor's Seal

Witnesses: William R. Wells, PLS

\6S25X21

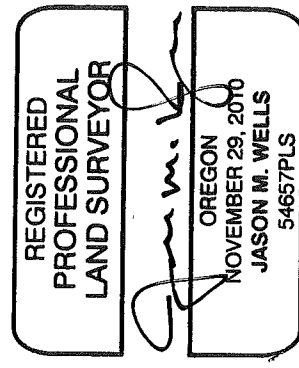

RENEWS: 6/30/12