


CERTIFIED RECORD OF LAND CORNER MONUMENTATION

Z-17.5

**History of original corner establishment:**

This monument was marked in 1879 by A. York under G.L.O contract No. 309. He described it as a Pine, 36" dia. It was found in 1881 by F.W. Sanderson during his retracement under G.L.O. contract No. 368. He described it as a Pine on line 24" dia., and found it to be 1.00 chain West of the corner to Secs. 34 and 35 set by him.

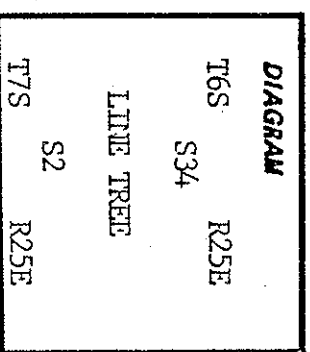

**Description of corner evidence found:**

I found a dead P. Pine, 42" dia., with axe work on East and West sides. This tree lies 62.5 feet westerly from the corner to Secs. 34 and 35 recovered by Kurt Weaver, L.S. 1679, in his survey of 1980.

**Description of monument and accessories | established to perpetuate the original location of this corner:**

I added an "attention" sign and a 6" red enamel stripe to the line tree from which:


White Fir, 24" dia., bears N32 3/4°W, 18.6 ft.

Scribed: "AP S34 BT"

Douglas Fir, 18" dia., bears S38 1/2°W, 43.6 ft.

Scribed: "AP S2 BT"

The B.T.'s have an "attention" sign, a B.T. tag, a 6" red enamel stripe and an alum. "PLS 1832" washer.

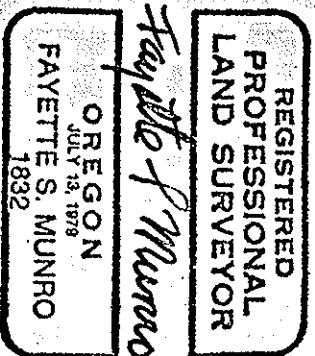

*Fayette S. Munro*

10/24/84  
MUD  
-K  
702

Office of..... *SUPREYAR* ..... County of..... *MARION Co.* .....  
 State of..... *OREGON* ..... I hereby certify that the within instrument was filed in this office  
 for record on the..... day of..... *JULY* ..... , 19*84*  
*David A. K. [Signature]* ..... by .....  
 (COUNTY OFFICIAL) (DEPUTY)