

CERTIFIED RECORD OF LAND CORNER MONUMENTATION


T6S, R25E

2-9

History of original corner establishment:

This corner was established by E.W. Sanderson in 1881 during his retracement under G.L.O. contract No. 368. He set a stone 18"x14"x8" in a stone mound from which:

- A pine, 24" dia, bears S60° E, 59 links
- A pine, 24" dia, bears N50°W, 70 links

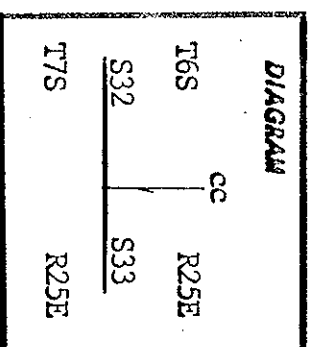

Description of corner evidence found:

I found 2 pine B.T.'s, from the corner point, established at record distance:

- P. pine, 31" dia, bears N42°W, 46.2 ft. with scribing visible on open blaze
- P. pine, 28" dia, bears S68½°E, 38.9 ft. with scribing visible on open blaze


I found no evidence of the original corner monument.

Description of monument and accessories I established to perpetuate the original location of this corner:

I set a 2½"x30" alum. pipe in a stone mound with a 3" alum. cap containing a magnet and marked:

Then to the original B.T.'s I added an "attention" sign, a B.T. tag and a 6" red enamel stripe.

There is a 6' steel fence post with an "attention" sign within 5' of the corner.

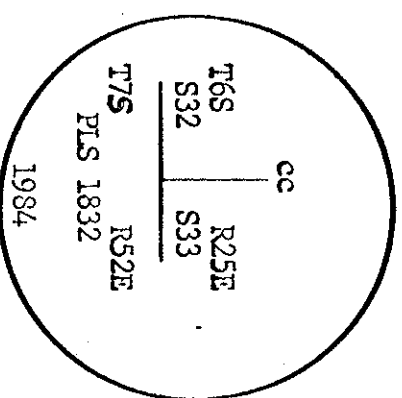

REGISTERED PROFESSIONAL LAND SURVEYOR

Fayette S Munro

OREGON JULY 13, 1979 FAYETTE S. MUNRO 1832

RECEIVED BY

Morrow County Surveyor

Date 10/24/84

Rec'd by MLD

No. 696-1c

Office of..... SURVEYOR..... County of..... Morrow.....

State of..... OREGON..... I hereby certify that the within instrument was filed in this office

for record on the..... day of..... July....., 1984

..... David H. Klein..... by..... (DEPUTY)

(COUNTY OFFICIAL)