

CERTIFIED RECORD OF LAND CORNER MONUMENTATION

A - 5
DIAGRAM



History of original corner establishment:

The original corner was established by Edward W. Sanderson on April 21, 1881, under GLO contract No. 368, as follows:

Set a stone, 14" x 12" x 4", in a stone mound for the closing corner to sections 5 and 6, at the intersection of the first standard parallel south, 35 chains and 50 links west of the corner to Township 5 S., Ranges 25 and 26 E., from which:

- A 18" pine bears N15° E, 38 links (25.08 feet).
- A 24" pine bears S20° E, 114 links (75.24 feet).

Original corner evidence recovered:

Found the original corner stone loosely set in a of a mound of stones. The corner stone is 15" x 12" x 5" and is plainly marked with six grooves on one face, from which:


- A 24" sawn Ponderosa Pine stump, with scribes "BT" visible on a nearly healed blaze, bears N 24° E, 26.1 feet.
- A large, down and decayed Ponderosa Pine, with scribes "T6S R26E S6 BT", visible on double blazes. Root hole bears S3° E, 73.4 feet.

Monument and accessories established to perpetuate the original position of this corner:

In place of the original corner stone, I set a 1" x 30" flared, galvanized iron pipe 26" into the ground. A 2 1/2" brass cap attached to the top of the pipe is marked as shown in the diagram above. I bury the corner stone along the west side of the pipe and build a mound of stones around the pipe, from which:

- A 8" Ponderosa Pine, scribed "R25E BT", bears N51° E, 39.5 feet.
 - A 11" Ponderosa Pine, scribed "T6S R26E S5 CC BT", bears S62° 30' E, 16.2 feet.
 - A 9" Ponderosa Pine, scribed "T6S R26E S6 CC BT", bears S35° W, 38.4 feet.
 - A 10" Ponderosa Pine, scribed "T5S BT", bears N18° 30' W, 19.5 feet.
- The standard 1/4 corner, S36, on the first standard parallel south, bears West, 28.6 feet. The new bearing trees are scribed on double blazes and have a 3/4" brass washer, marked "PLS 1636", nailed flush to the bottom of the lower blaze.

I hereby certify the above corner position was perpetuated as hereon described on May 16, 2003. Magnetic declination set in compass: 17° E. NAD 83 UTM Zone 11 position: 4995399N 291632E (plus or minus two meters)

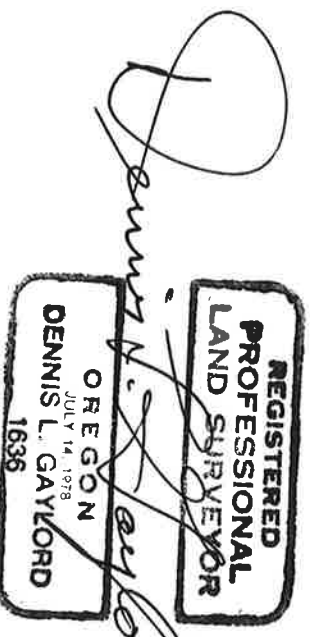

RECEIVED BY
Morrow County Surveyor

Date: 1-04-2014
 Rec'd By: S.K.H.
 No.: 6526AA
 Folder No.: _____

Renews June 30, 2003

Recorded at the office of County Surveyor, County of Morrow, State of Oregon, on: