


History of original corner establishment:

The original corner was established by Ed Sanderson under G.L.O. contract 368, dated September 7, 1880. His record reads:

Set Stone 24x10x6 in stone mound for 1/4  
 Sec. cor. from which  
 a pine 18 in dia bears S22° W 56 lks  
 " " 30 " " " N70° E 75 "

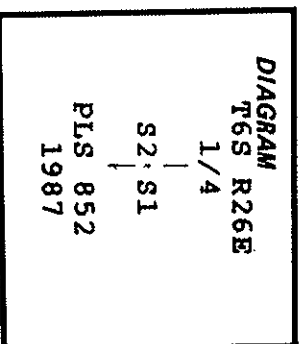

Description of corner evidence found:

Found 22x12x7 stone with 1/4 marked on face in stone mound. Found 26" ponderosa pine scribed 1/4 S in open blaze which bears S22° W, 36.0'. Found stump with BT scribe near base and the log lying nearby with 1/4 S scribe showing but turned toward the ground. The stump bears S59° 40' W, 49.1'.

Description of monument and accessories | established to perpetuate the original location of this corner:

Set a 2" I.D. galvanized iron pipe 30" long with 2 1/2" brass cap 26" into the ground and stamped the cap as shown in diagram above. Buried the original stone along side the monument.

Placed a 3' diameter mound of stone around the monument and set a steel fence post 5' south of the monument with Forest Service Land Survey Monument and sign attached.

Scribed 1/4 SI BT on a 7" ponderosa pine which bears N82° 34' E, 13.7'. The bearings are based on the bearing of the live bearing tree. Each scribe is in a 24" blaze. Nailed an aluminum washer, stamped RLS 852, between the letters B and T on each tree. Painted a 6" red band around the new and old bearing trees and attached Forest Service Land Survey Monument and Bearing Tree signs.

I certify the above corner point was perpetuated as hereon described on ~~August 14~~, 1987.  
*September 18,*

REGISTERED  
 PROFESSIONAL  
 LAND SURVEYOR

*David L. Haddock*

OREGON  
 JULY 12, 1966  
 DAVID L. HADDOCK  
 852

 State of OREGON I hereby certify that the within instrument was filed in this office  
 for record on the 19 day of DECEMBER, 1996  
DAE by .....  
 (COUNTY OFFICIAL) (DEPUTY)