


CERTIFIED RECORD OF LAND CORNER MONUMENTATION

Index File No. E-21

History of original corner establishment:

The original corner was established by Ed Sanderson under G.L.O. contract 368, dated September 7, 1880. His record reads:

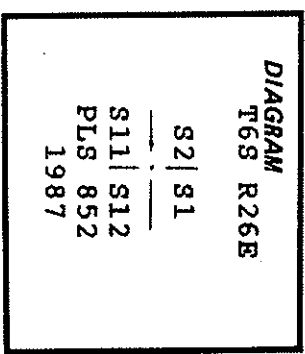

Set stone 10x8x8 in stone mound for cor. to secs. 11-12-1&2 from which
 A pine 24 in dia. bears N62°E. 71 lks-
 " " 18 " " S54°E. 88 "
 " " 24 " " S.76°W.56 "

Description of corner evidence found:
 Found stone 10x8x8 with 5 notches on the south face and 3 notches turned down in a stone mound.

Found Ponderosa Pine stump with BT fragment at base which bears N63°05'W, 47.8'. Found Ponderosa Pine stump with BT fragment at base which bears S54°53'E, 57.6'. Found Ponderosa Pine stump with BT scribe at base which bears S76°02'W, 35.1'.

Description of monument and accessories | established to perpetuate the original location of this corner:

Set a 2" I.D. galvanized iron pipe 30" long with 2 1/2" brass cap 26" into the ground and stamped the cap as shown in diagram above. Buried the original stone along side the monument.

Placed a 3' diameter collar of stone around the monument and set a steel fence post 5' north of the monument with Forest Service Land Survey Monument sign attached.

Scribed T6S R26E S1 BT on a 9" Ponderosa Pine which bears N62° 28'E, 19.7'. Scribed T6S R26E S12 BT on a 9" Ponderosa Pine which bears S34°43'E, 20.6'. Scribed T6S R26E S11 BT on a 9" Douglas Fir which bears S29°02'W, 6.1'. Scribed T6S R26E S2 BT on a 13" Douglas Fir which bears N12°12'W, 14.4'. Each scribe is in a 36" blaze. The bearings are true. Nailed an aluminum washer, stamped RLS 852, between the letters B and T on each new bearing tree. Painted a 6" red band around both old and new bearing trees and attached Forest Service Land Survey Monument and Bearing Tree signs.

I certify the above corner point was perpetuated as hereon described on September 18, 1987.

REGISTERED PROFESSIONAL LAND SURVEYOR

David L. Haddock

OREGON JULY 12, 1988 DAVID L. HADDOCK 852
--

 State of OREGON I hereby certify that the within instrument was filed in this office
 for record on the 19 day of DECEMBER, 1986
IDE by DAVID L. HADDOCK
 (COUNTY OFFICIAL) (DEPUTY)