


CERTIFIED RECORD OF LAND CORNER MONUMENTATION

E - 3
DIAGRAM

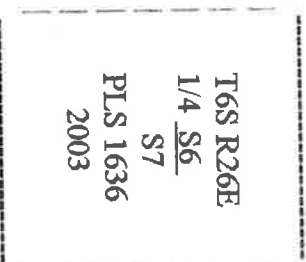

History of original corner establishment:

The original corner was established by Edward W. Sanderson on April 21, 1881, under GLO contract No. 368, as follows:

Set a stone, 18" x 12" x 7", in a stone mound for 1/4 section corner, from which:

- A 20" pine bears S40° W, 32 links (21.12 feet).
- A 30" pine bears S30° E, 35 links (23.10 feet).

Original corner evidence recovered:

The original corner stone is gone, as the corner point falls in a deeply cut skid trail.

Found the original bearing trees as follows:


- A 30" sawn Ponderosa Pine stump with scribes, "BT", visible on a partly healed lower blaze bears S25° E, 23.1 feet.
- A 20" high cut, sawn Ponderosa Pine uprooted stump with scribes, "1/4S BT", visible on double blazes. Root hole bears S42° W, 21.1 feet.

Monument and accessories established to perpetuate the original position of this corner:

At the corner position determined by intersection of record distances from the original bearing tree evidence, I set a 1" x 30" flared, galvanized iron pipe 27" into the ground. I build a mound of stones around the pipe. A 2 1/2" brass cap attached to the top of the pipe is marked as shown in the diagram above, from which:

- A 9" Ponderosa Pine, scribed "1/4 S6 BT", bears N1° E, 29.8 feet.
 - A 5" Ponderosa Pine, scribed "1/4 S7 BT", bears S70° 30' E, 23.7 feet.
 - A 7" Ponderosa Pine, scribed "1/4 S7 BT", bears S35° 30' W, 22.3 feet.
 - A 7" Ponderosa Pine, scribed "1/4 S6 BT", bears N37° 30' W, 40.1 feet.
- Each of the new bearing trees is scribed on double blazes and has a 3/4" brass washer, marked "PLS 1636", nailed flush to the bottom of the lower blaze.

I hereby certify the above corner point was perpetuated as hereon described on May 5, 2003.
Magnetic declination set in compass: 17° E.
NAD '83 UTM Zone 11 position: 4993936N 290735E (plus or minus two meters).

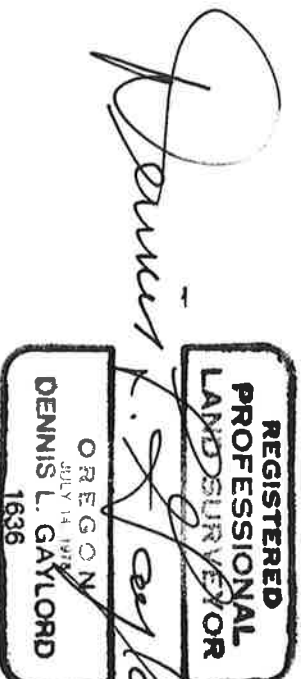

RECEIVED BY
Morrow County Surveyor
Date: 1-4-2014
Recd By: S.K.H.
No.: 6526E3
Folder No.: _____

Renews June 30, 2003

Recorded at the office of County Surveyor, County of Morrow, State of Oregon, on: