


CERTIFIED RECORD OF LAND CORNER MONUMENTATION

E - 5
DIAGRAM

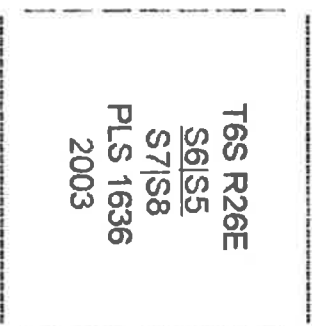

History of original corner establishment:

The original corner was established by Edward W. Sanderson on April 21, 1881, under GLO contract No. 368, as follows:

Set a stone, 24" x 10" x 8", in a mound of stones for the corner to sections 5, 6, 7 & 8, from which:

- A 30" pine bears S60° W, 99 links (65.34 feet).
- A 30" pine bears S45° E, 42 links (27.72 feet).

Original corner evidence recovered:

Found the original corner stone solidly set in a mound of stones. The corner stone is 20" x 12" x 8" and has no visible marks, from which:

- A sawn, 5 foot high by 33" diameter Ponderosa Pine stump with double healed blazes bears S2° E, 27.0 feet.
- A sawn and decayed 30" diameter Ponderosa Pine stump with scribes, "BT", visible, bears S84° W, 63.1 feet.


Monument and accessories established to perpetuate the original position of this corner:

In place of the original corner stone, I set a 1" x 30" flared, galvanized iron pipe 12" into the ground to bedrock. A 2 1/2" brass cap attached to the top of the pipe is marked as shown in the diagram above. I bury the corner stone along the southwest side of the pipe and build a mound of stones around the pipe, from which:

- A 5" Juniper, scribed "T6S R26E S5 BT", bears N13° 30' E, 61.8 feet.
- A 10" Ponderosa Pine, scribed "T6S R26E S8 BT", bears S39° E, 58.1 feet.
- A 11" Ponderosa Pine, scribed "T6S R26E S7 BT", bears S78° W, 77.7 feet.
- A 8" Ponderosa Pine, scribed "T6S R26E S6 BT", bears N74° 30' W, 26.3 feet.

The bearing trees are scribed on double blazes and have a 3/4" brass washer, marked "PLS 1636", nailed flush to the bottom of the lower blaze.

I hereby certify the above corner point was perpetuated as hereon described on June 12, 2003. Magnetic declination set in compass: 17° E.
NAD '83 UTM Zone 11 position: 4993912N, 291571E (plus or minus two meters).

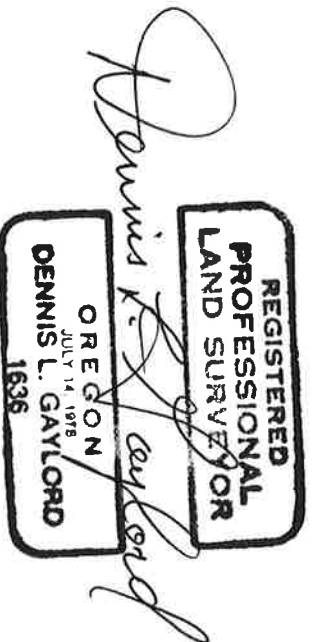

RECEIVED BY
Morrow County Surveyor

Date: 1-4-14
 Recd By: S.K.H.
 No.: 6526E5
 Folder No.: _____

Renews June 30, 2005

Recorded at the office of County Surveyor, County of Morrow, State of Oregon, on: