


CERTIFIED RECORD OF LAND CORNER MONUMENTATION

E - 7
DIAGRAM

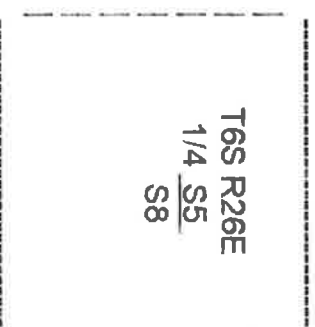

History of original corner establishment:

The original corner was established by Edward W. Sanderson on April 21, 1881, under GLO contract No. 368, as follows:

Marked a 12" fir for the 1/4 section corner to sections 5 and 8, from which:

- A 36" pine bears S45° E, 29 links (19.14 feet).
- A 12" fir bears North, 35 links (23.10 feet)

Original corner evidence recovered:

The original corner tree is a 22" sawn Douglas-fir stump with axe marks on the west side, from which:

- A 24" sawn Douglas-fir stump with a healed lower blaze bears N 5° W, 22.8 feet.
- The badly decayed remains of a large Ponderosa Pine, root hole bears S45° E, 21.0 feet.

Monument and accessories established to perpetuate the original position of this corner:

I drive a 5/8" x 24" iron rod into the center of the original corner tree so the top of the rod is flush to the top of the stump. I attach a 3/4" brass washer, marked "PLS 1636", to the rod, from which:

- A 12" White Fir, scribed "1/4 S5 BT", bears N20° E, 32.4 feet.
- A 9" Ponderosa Pine, scribed "1/4 S8 BT", bears S67° 30' E, 73.3 feet.
- A 8" Ponderosa Pine, scribed "1/4 S8 BT", bears S30° W, 28.9 feet.
- A 7" Ponderosa Pine, scribed "1/4 S5 BT", bears N53° 30' W, 25.7 feet.

The new bearing trees are scribed on double blazes and have a 3/4" brass washer, marked "PLS 1636", nailed flush to the bottom of the lower blaze.

I hereby certify the above corner point was perpetuated as hereon described on June 12, 2003. Magnetic declination set in compass: 17° E. NAD '83 UTM Zone 11 position: 4993888N, 292375E (plus or minus two meters).



RECEIVED BY
Morrow County Surveyor

Date: 1-4-14
 Recd By: S.K.H.
 No.: 6526E7
 Folder No.: _____

Renews June 30, 2005

Recorded at the office of County Surveyor, County of Morrow, State of Oregon, on: