


CERTIFIED RECORD OF LAND CORNER MONUMENTATION

Index File No. J-22

History of original corner establishment:

This corner not previously established.

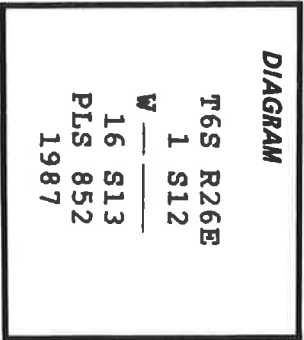

Description of corner evidence found:
K tag indicates west 1/16 in general area.

Description of monument and accessories | established to perpetuate the original location of this corner:

Set a 2" I.D. galvanized iron pipe 30" long with 2 1/2" brass cap 8" into the ground and stamped the cap as shown in diagram above.

Placed a 3' diameter mound of stone around the monument and set a steel fence post 5' north of the monument with Forest Service Land Survey Monument and Property Boundary signs attached.

Scribed W1/16 S12 BT on a 17" Ponderosa Pine which bears N12°26'W, 460.6'. Scribed W1/16 S13 BT on a 6" Juniper which bears S71°48'W, 217.9'. Each scribe is in a 24" blaze. The bearings are true.

Nailed an aluminum washer, stamped RLS 852, between the letters B and T on each new bearing tree. Painted a 6" red band around new bearing trees and attached Forest Service Land Survey Monument and Bearing Tree signs.

I certify the above corner point was established as hereon described on September 18, 1987.

REGISTERED
PROFESSIONAL
LAND SURVEYOR

David L. Haddock

OREGON
JULY 12, 1966
DAVID L. HADDOCK
852

Office of GOV. COUNTY SURVEYOR County of MORROW
State of OREGON I hereby certify that the within instrument was filed in this office
for record on the 18 day of DECEMBER, 1987
D.L.E. by
(COUNTY OFFICIAL) (DEPUTY)