

EXHIBIT 'A'

M-29850


CERTIFIED RECORD OF LAND CORNER MONUMENTATION

Index File No. J-23

History of original corner establishment:

The original corner was established by Ed Sanderson under G.L.O. contract 368, dated September 7, 1880. His record reads:

Set Stone 14x14x4 in stone mound for 1/4 sec. cor

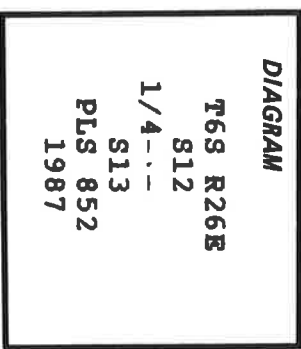

Description of corner evidence found:

Found 13x16x5 stone with 1/4 marked on face which was turned down in stone mound. Similar stone in mound 20 east had no markings.

Description of monument and accessories | established to perpetuate the original location of this corner:

Set a 2" I.D. galvanized iron pipe 30" long with 2 1/2" brass cap 10" into the ground and stamped the cap as shown in diagram above. Buried the original stone along side the monument.

Placed a 3' diameter mound of stone around the monument and set a steel fence post 5' west of the monument with Forest Service Land Survey Monument and sign attached.

Scribed 1/4 S12 BT on a 16" Ponderosa Pine which bears N79°40'E, 60.3'. Scribed 1/4 S13 BT on a 9" Ponderosa Pine which bears S20°47'W, 16.9'. The bearings are true. Each scribe is in a 24" blaze. Nailed an aluminum washer, stamped RLS 852, between the letters B and T on each tree. Painted a 6" red band around the new bearing trees and attached Forest Service Land Survey Monument and Bearing Tree signs.

I certify the above corner point was perpetuated as hereon described on ~~August 14~~, 1987.
 September 18,

REGISTERED PROFESSIONAL LAND SURVEYOR
<i>David L. Haddock</i>
OREGON JULY 12, 1968 DAVID L. HADDOCK 852

Office of Surveyor County of Morrow
State of OREGON I hereby certify that the within instrument was filed in this office
for record on the 18 day of DECEMBER, 1996
JDE by _____
(COUNTY OFFICIAL) (DEPUTY)