


CERTIFIED RECORD OF LAND CORNER MONUMENTATION

C-1

DIAGRAM T6S R26E

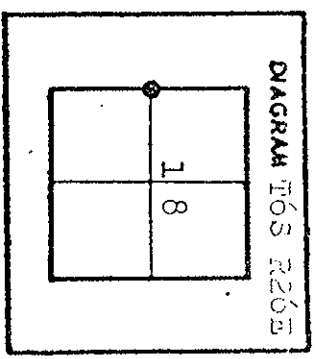

History of original corner establishment:

Corner originally established by E. W. Sanderson under contract no., 368, dated Sept. 7, 1880.

Government field notes state:

Set stone 16x16x8 in stone mound for 1/4 sec. cor.

Description of corner evidence found:

I found an unmarked basalt stone 16"x12"x5" firmly set in a mound of stone, oriented properly for a 1/4 corner stone. I accept the position of this stone for the West 1/4 corner of Sec. 18 as it is harmoniously related to other existing original corners in the area.

See my recorded Map of Survey dated Oct. 1980.

Description of monument and accessories established to perpetuate the original location of this corner

At the corner point:

Set a 1 1/2"x30" iron pipe 10" in the ground with brass cap marked as shown:

From which I scribe NEW BEARING TREES:

A Juniper 11" in diam. bears N. 13° E., 15.4 ft. mkd. 1/4 S18 BT.

A Juniper 4" in diam. bears S. 73° E., 127.0 ft. mkd. 1/4 S18 BT.

Buried corner stone North and alongside iron pipe and raised a mound of stone, 4 ft. base around pipe to top of cap.

Used magnetic compass with 20° East variation and steel tape, measuring to face of BT blaze.

Done Oct. 27, 1980.

Witness: G. L. Earl, O.P.L.S.

T6S R26E
1/4 S18
1980
OPLS 598
BRASS CAP
MARKED

REGISTERED
PROFESSIONAL
LAND SURVEYOR

Robert D. Baggett
OREGON
JULY 12, 1963
ROBERT D. BAGGETT
598

Office of.....SURVEYOR..... County of.....MORROW.....
State of.....OREGON....., I hereby certify that the within instrument was filed in this office
for record on the 10 day of.....November,.....1980..
Robert D. Baggett
(COUNTY OFFICIAL)..... by..... (DEPUTY)

RECEIVED BY

Morrow County Surveyor

Date 11-10-80

Rec'd By Wm. S. J.

No. # 407-K

refer to survey no. #398-K